

7-5-98

Trigonometrical Survey of N.S.W.

RECONNAISSANCE and MAINTENANCE REPORT

Department of Lands

STATION GERINGONG

TS 2168

This Trig. Station has been:-

Note: Cross out word or words which do not apply

1. Completely cleared to permit 360° vision to surrounding Trigs.

2. ~~Cleared by vanes bearing~~

3. ~~Trig. Mast & Vanes have been painted white & black respectively~~

4. The Trig. was unpiled/~~not unpiled~~, dimensions now being: See note overleaf

Description of mark.....Brass Plug..... should be explicit, e.g. Steel plug, Brass plug, Bolt, G.I. Pipe

Height of mark.....0.....m above rock/concrete .....0.5.....m above below G.I.

Height of Top Vanes to Top Mark.....m Diameter of Vanes (vertical).....m

Height of Cairn.....m Diameter of Cairn.....m

Length of Mast.....1.52.....m. (approximate if not unpiled) White Post no Vanes

5. A..... set in conc/rock has been placed.....m. bearing.....°M from Trig. Mast

6. A..... set in conc/soil has been placed.....m. bearing.....°M from Trig. Mast

7. A..... set in conc/soil has been placed.....m. bearing.....°M from Trig. Mast

8. A..... set in conc/rock has been placed.....m. bearing.....°M from Trig. Mast

9. Connection.....to.....m. bearing.....°M

10. Connection.....to.....m. bearing.....°M

11. Connection.....to.....m. bearing.....°M

12. Connection.....to.....m. bearing.....°M

13. Diff. Ht. .... is.....m. above below

14. Diff. Ht. .... is.....m. above below

15. Diff. Ht. .... is.....m. above below

16. Diff. Ht. .... is.....m. above below

Prepared by:

Checked:

Noted on U.T.M. Card

Checked


Co: CAMDEN Ph: BROUGHTON

Map Sheet: KIAMA No: 9028

Inspected by: J.H. GILLIES Date: 3.12.75

Authority: D.M.R. Field Book: -

Beacon Diagram Not to Scale

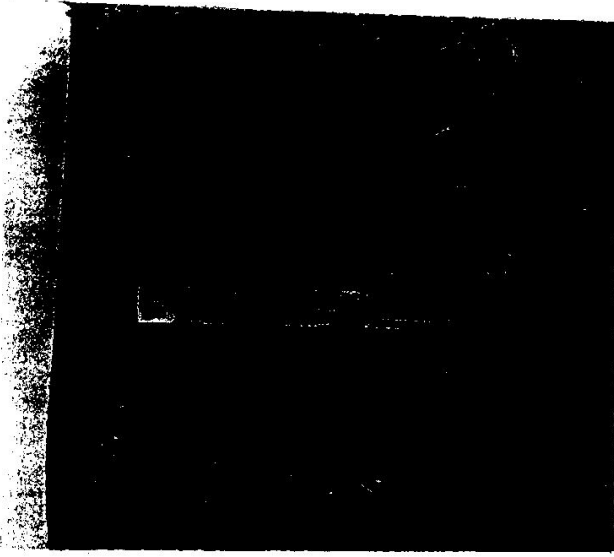

Date Record of Station







STATIONS 2168 GERRINGONG

Owners Name ..... Current Occupant .....

Address ..... Address .....

Access Size KIANGA 1:25000 map

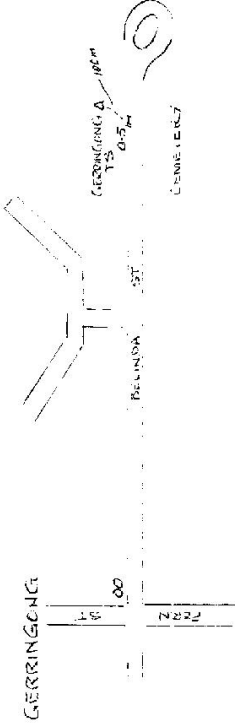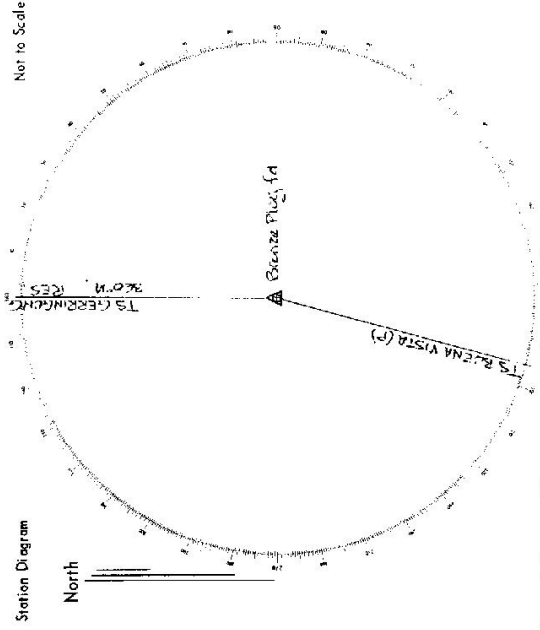

List of Observed Directions:-

Standpoint: Breeze Plus		Standpoint:	
Station	Direction	Station	Direction
TS GERRINGONG RES	070.40		
TS BUENA VISTA (P)	191.24 51.1		

D. West, Government Printer, New South Wales - 1976

CENTRAL MAPPING AUTHORITY

Trigonometrical Survey of N.S.W.

Department of Lands

RECONNAISSANCE and MAINTENANCE REPORT

STATION GERJINGONG TS 2168

This Trig. Station has been:-

Note: Cross out word or words which do not apply

1. Completely cleared to permit 360° vision to surrounding Trigs.

2. ~~Cleared by Vanes-bearing~~ ~~from Trig-Mast~~

3. ~~Trig-Mast & Vanes have been painted white & black respectively~~

4. The Trig. was unpiled/~~not unpiled~~, dimensions now being: See note overleaf

Description of mark..... ~~Brass Plug~~ ..... should be explicit, e.g. Steel plug, Brass plug, Bolt, G.I. Pipe

Height of mark..... 0..... m above rock/concrete ..... 0.5..... m <sup>above</sup> below G.I.

Height of Top Vanes to Top Mark..... m ..... Diameter of Vanes (vertical)..... m

Height of Coin..... m ..... Diameter of Coin..... m

Length of Mast 1.52..... m. (approximate if not unpiled) White Post no Vanes

5. A..... set in conc/rock has been placed..... m. bearing..... °M from Trig. Mast

6. A..... set in conc/soil has been placed..... m. bearing..... °M from Trig. Mast

7. A..... set in conc/soil has been placed..... m. bearing..... °M from Trig. Mast

8. A..... set in conc/rock has been placed..... m. bearing..... °M from Trig. Mast

9. Connection..... to..... : ..... m. bearing..... °M

10. Connection..... to..... : ..... m. bearing..... °M

11. Connection..... to..... : ..... m. bearing..... °M

12. Connection..... to..... : ..... m. bearing..... °M

13. Diff. Ht. .... is..... m. <sup>above</sup> below

14. Diff. Ht. .... is..... m. <sup>above</sup> below

15. Diff. Ht. .... is..... m. <sup>above</sup> below

16. Diff. Ht. .... is..... m. <sup>above</sup> below


Prepared by:

Checked:

Noted on U.T.M. Card

Checked

Beacon Diagram Not to Scale

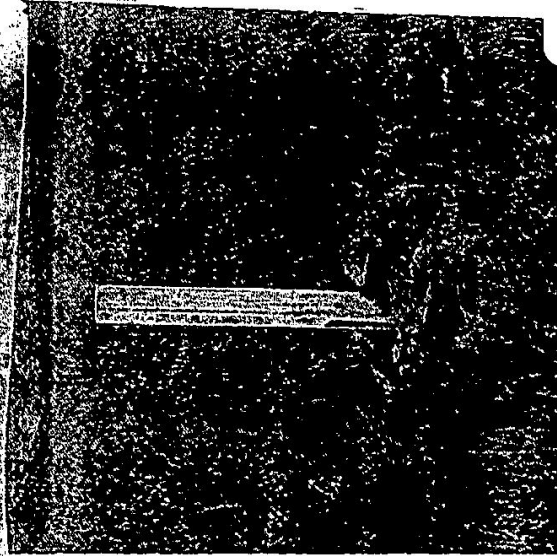

Date	Record of Station

TS2168




STATION GERINGONG TS 2168

Owners Name..... Not Known.....  
 Current Occupant..... Nil.....  
 Address.....  
 Address.....

Access As per trig card. 3-12-1975


Note: Original brass trig plug found loose in stone with top broken off.  
 Base of plug replaced in original hole in stone and fixed with epoxy resin. Centre of plug marked with 2 chisel cuts. Top of plug now same level as rock. See photograph below.

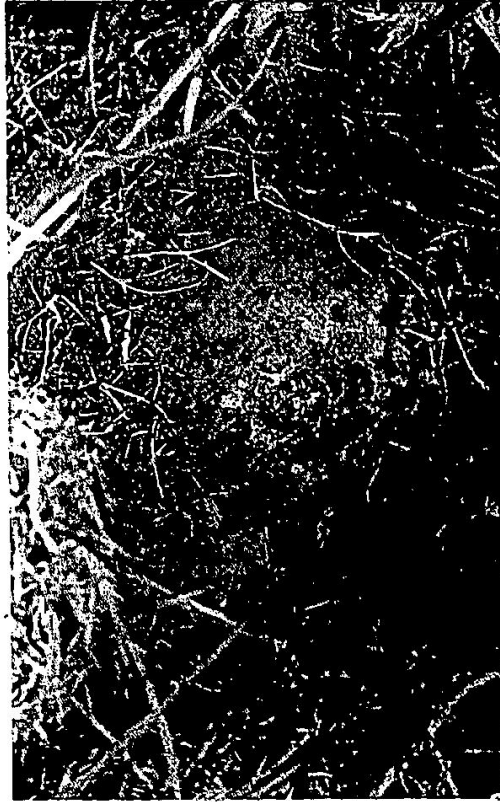

Not to Scale

on Diagram

orth

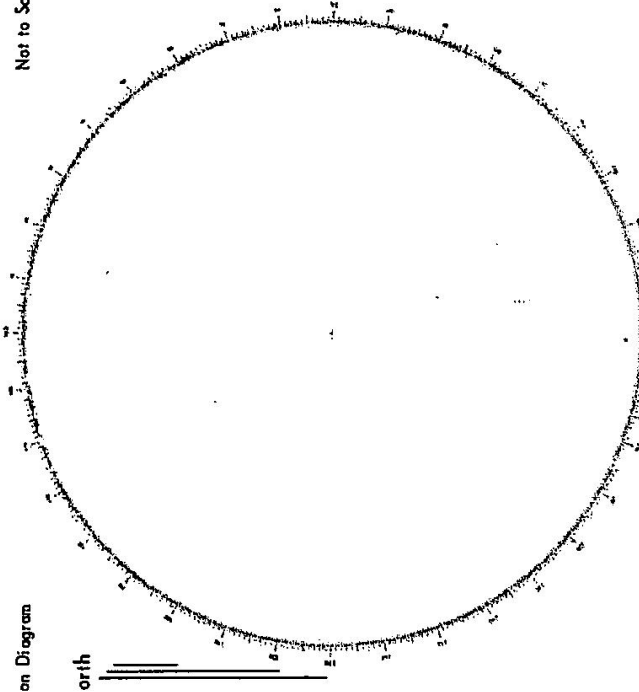

of Observed Directions:—

Standpoint:	
Station	Direction
.....	.....
.....	.....
.....	.....
.....	.....

Standpoint:	
Station	Direction
.....	.....
.....	.....
.....	.....
.....	.....




STATION TS 2168, GERRINGONG TS.

Owners Name.....  
 Address.....  
 Access.....


Current Occupant.....  
 Address.....

Station Diagram

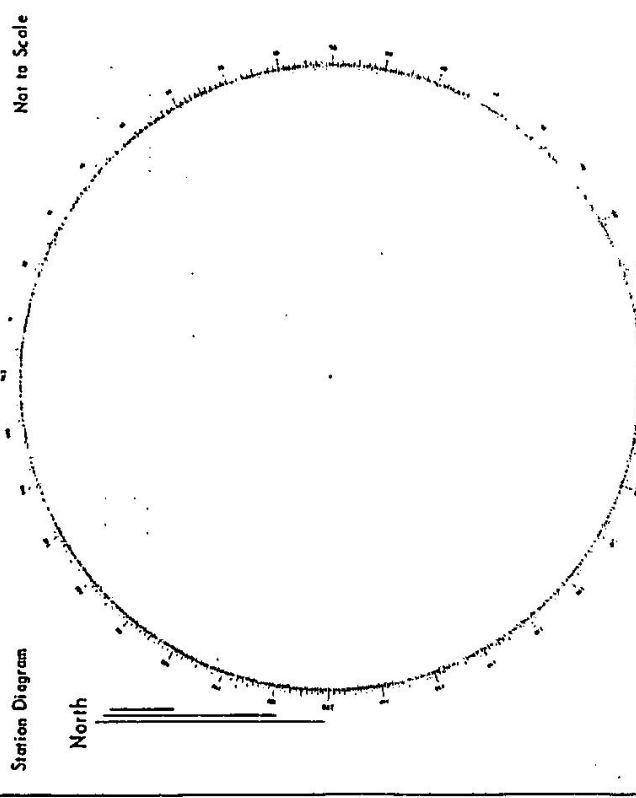


List of Observed Directions:-

Stationpoint:		Stationpoint:	
Station	Direction	Station	Direction

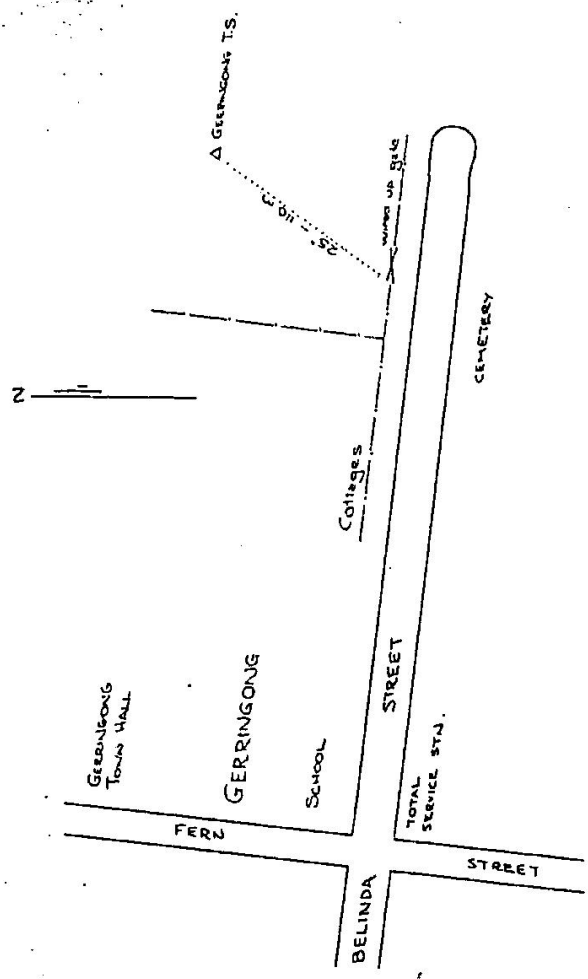







STATIONTS 2168S  GERRINGONG

Owners Name.....  
 Current Occupant.....  
 Address.....  
 Address.....

Access Size KIAWA 1:25000 map.

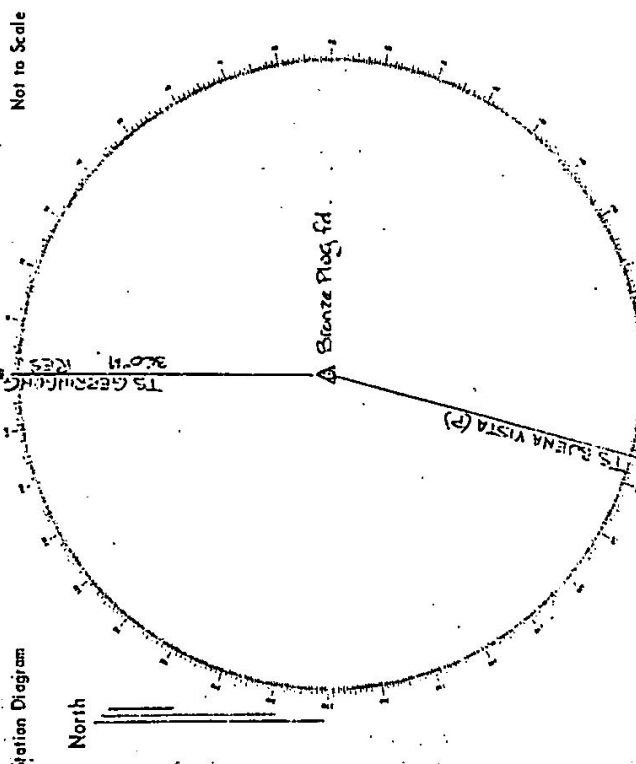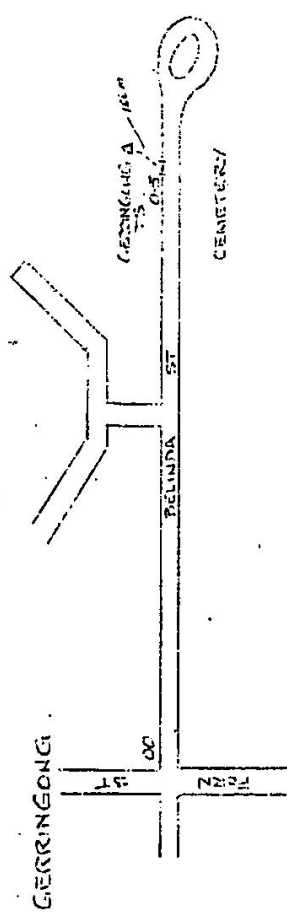

List of Observed Directions:-

Standpoint: Bronze Plug		Standpoint:	
Station	Direction	Station	Direction
TS GERRINGONG RES	0° 00' 00"		
TS BUENA VISTA (P)	101° 24' 51.1"		

01. World Data Bank Report 1991, New South Wales - 1976