

7-4-98

Trigonometrical Survey of N.S.W.

CENTRAL MAPPING AUTHORITY

Department of Lands

RECONNAISSANCE and MAINTENANCE REPORT

STATION *GEORGE OS RIVER TS 2171*

This Trig. Station has been:-

Note: Cross out word or words which do not apply

1. Completely cleared to permit 360° vision to surrounding Trigs.
2. Cleared by lances bearing..... from Trig. Mast
3. Trig. Mast & Vanes have been painted white & black respectively.  Original Station Mark found / not found
4. The Trig. was unpiled/not unpiled, dimensions now being: .....

Description of mark..... should be explicit, e.g. Steel plug, Brass plug, Bolt, G.I. Pipe

Height of mark..... m <sup>above</sup> / <sub>below</sub> rock/concrete ..... m <sup>above</sup> / <sub>below</sub> G.L.  
 Height of Top Vanes to Top Mark..... m. Diameter of Vanes (vertical)..... m.

Height of Cairn..... m. Diameter of Cairn..... m.

- Length of Mast..... m. (approximate if not unpiled)
5. A..... set in conc/rock has been placed..... m. bearing.....°M from Trig. Mast
  6. A..... set in conc/soil has been placed..... m. bearing.....°M from Trig. Mast
  7. A..... set in conc/soil has been placed..... m. bearing.....°M from Trig. Mast
  8. A..... set in conc/rock has been placed..... m. bearing.....°M from Trig. Mast

9. Connection..... to..... : ..... m. bearing.....°M

10. Connection..... to..... : ..... m. bearing.....°M

11. Connection..... to..... : ..... m. bearing.....°M

12. Connection..... to..... : ..... m. bearing.....°M

13. Diff. Ht. .... is..... m. <sup>above</sup> / <sub>below</sub>

14. Diff. Ht. .... is..... m. <sup>above</sup> / <sub>below</sub>

15. Diff. Ht. .... is..... m. <sup>above</sup> / <sub>below</sub>

16. Diff. Ht. .... is..... m. <sup>above</sup> / <sub>below</sub>

Prepared by: *[Signature]*


Checked:

Noted on U.T.M. Card

Co: *LINCOLN* Ph: *PHILLIPS*  
 Map Sheet: *D4660* No: *373*  
 Inspected by: *P. POTTS* Date: *23/12/76*  
 Authority: \_\_\_\_\_  
 Field Book: \_\_\_\_\_

Beacon Diagram

Not to Scale

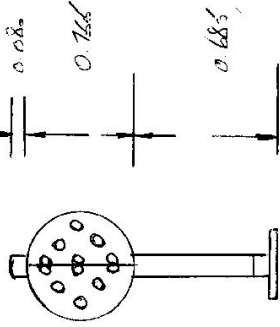

Date

Record of Station

*23/12/76*  
*New stone and stone inserted*  
*Name plate found intact*

Checked



GEODETIC SURVEY OF N.S.W.

CENTRAL MAPPING AUTHORITY

GEODETIC STATION RECONNAISSANCE and MAINTENANCE REPORT

Description: *360 m.* Note: *Cross out word or words which do not apply*

1. Cleared by lances bearing..... *360 m.*..... from Trig. Mast

2. Mast & Vanes have been painted white & black respectively. ✓

3. The ~~station~~ pillar was ~~replaced~~ *visited* on *26 November 81*, dimensions now being:

Description of mark..... should be explicit, e.g., S/Steel Pillar Plate, Steel plug, Brass plug, Bolt, G.I. Pipe

Height of mark..... *1.285* m. *above* ~~rock~~ *concrete*; *Mark is 1.425 m. above G.L.*

Height of Top Vanes to Top ~~mark~~ Pillar plate..... *1.320* m. Diameter of Vanes (vertical)..... *0.750* m.

Height of Cairn..... m. Diameter of Cairn..... m. Name Plate found/~~not found~~/placed.

Length of Mast..... m. (approximate if not unplied)

4. A..... set in conc/rock has been placed/found, bearing..... M from Mast/Plug/Pillar

5. A..... set in conc/rock has been placed/found, bearing..... M from Mast/Plug/Pillar

6. A..... set in conc/rock has been placed/found, bearing..... M from Mast/Plug/Pillar

7. A..... set in conc/rock has been placed/found, bearing..... M from Mast/Plug/Pillar

8. Action required.....

*ONLY*

STANDPOINT:

Mark	Direction	Horiz. Distance	Height Difference	Mark	Direction	Horiz. Distance	Height Difference
	<i>N/A</i>		<i>above</i> standpt. <i>below</i>				<i>above</i> standpt. <i>below</i>
	<i>N/A</i>		<i>above</i> standpt. <i>below</i>				<i>above</i> standpt. <i>below</i>
			<i>above</i> standpt. <i>below</i>				<i>above</i> standpt. <i>below</i>
			<i>above</i> standpt. <i>below</i>				<i>above</i> standpt. <i>below</i>
Prepared by: *P. HARRIS* 7th December 81. Checked: *[Signature]*

Noted on U.T.M. Card

ST 2733-1

STATION: *Geurie ESP* No: *2171*

MAP SHEET SCALE 1:250 000 *Dubbo*

INSPECTED BY: *P. HARRIS* DATE: *26.11.81*

AUTHORITY: *C.M.A* FIELD BOOK: *01927*

Station Diagram

Checked

GS 24

STATION <i>GENIE S.S.P</i> TS: <i>2171</i>	Owner's Name: ..... Address: ..... Phone: ..... Current Occupant: ..... Address: ..... Phone: ..... Access Report of <i>26/11/1981</i> was found suitable/unsuitable.
Beacon Diagram <p style="font-size: small;">Not to Scale</p>	This section to be completed by officer constructing pillar. Original station mark found/not found. Description of mark: ..... Original beacon found/not found. Description of beacon: ..... Height Top of Vanes to Top Mark: .....m. Height of mark: .....m. above G.L. below Diameter of Vanes: .....m. Height of Cairn: .....m. Original Beacon has/has not been destroyed by me.
Date	Record of Station

CENTRAL MAPPING AUTHORITY

GEODETIC SURVEY OF N.S.W.

GEODETIC STATION RECONNAISSANCE and MAINTENANCE REPORT

Description:

1. Cleared by lanes bearing  $260^{\circ}$  m. Note: Cross out word or words which do not apply
  2. Mast & Vanes have been painted white & black respectively. ✓
  3. The station/pillar was ~~erected~~ <sup>VISITED</sup> on 30th JUNE 1985, dimensions now being: ~~erected~~ <sup>erected</sup> should be explicit, e.g., S/Steel Pillar Plate, Steel plug, Brass plug, Bolt, G.I. Pipe
- Description of mark: ~~erected~~ <sup>erected</sup>   
 Height of mark: 1.385 m. above rock/concrete; Mark is 1.425 m. above G.L. ✓   
 Height of Top Vanes to Top Mast/Pillar plate: 1.435 m. Diameter of Vanes (vertical): 0.760 m. ✓   
 Height of Cairn: .....m. Diameter of Cairn: .....m. Name Plate found/not found/placed.   
 Length of Mast: .....m. (approximate if not upright)   
 4. A.....set in conc/rock has been placed/ found, bearing.....°M from Mast/Plug/Pillar   
 5. A.....set in conc/rock has been placed/ found, bearing.....°M from Mast/Plug/Pillar   
 6. A.....set in conc/rock has been placed/ found, bearing.....°M from Mast/Plug/Pillar   
 7. A.....set in conc/rock has been placed/ found, bearing.....°M from Mast/Plug/Pillar   
 8. Action required:.....

STANDPOINT:

Mark	Direction	Horiz. Distance	Height Difference	Mark	Direction	Horiz. Distance	Height Difference
			above standpt.				above standpt.
			below standpt.				below standpt.
			above standpt.				above standpt.
			below standpt.				below standpt.
Prepared by: P. Potts 30th JUNE 1985 Checked: L.C.M.

Noted on U.T.M. Card

Checked: P. Potts 24.10.85

STATION: GRELURIE G.S.(P) No: 2171 TS

MAP SHEETS SCALE 1:250 000 Dubbo SCALE 1:100 000

INSPECTED BY: P. Potts DATE: 3.6.85

AUTHORITY: C.M.A. FIELD BOOK: 1956

Station Diagram

Not to Scale

SR 2733-2 D. West. Government Printer

STATION **GEURIE GSP** TS **2171**


Owner's Name: **IRIG RESERVE 16000**  
 Address: **CURRENT GEURIE H**  
 Dubs: **LBS. 28.5.85**  
 Phone: .....

Current Occupant: **MR. O. J. MORLEY**  
 Address: **BALD HILL**  
 Phone: **068 871327**

**ACCESS**

Access Report of **3.6.1985** was found suitable/unsuitable.

- KUL FEATURE**
- 0.00. POST OFFICE GEURIE HEAD WEST
  - 0.43. TURN LEFT ON BRUNNEN FOLLOWING GRAVEL ROAD
  - 1.34. PASS GRAVEL ROAD ON RIGHT
  - 1.78. TURN LEFT SIGN "BALD HILL"
  - 2.37. MR MORLEY'S HOUSE ON RIGHT
  - 2.40. TURN LEFT THROUGH WHITE DOUBLE IRON GATES
  - THEN KEEP LEFT TOWARDS FENCE, FOLLOW THIS FENCE
  - 2.88. TO END OF PADDOCK TO IRON GATE
  - IRON GATE NEXT TO KURRATIONS TREE
  - FROM HERE MAKE OWN WAY UP FAIRLY SHEEP HILL TO TRIS
  - 3.33. GEURIE GSP

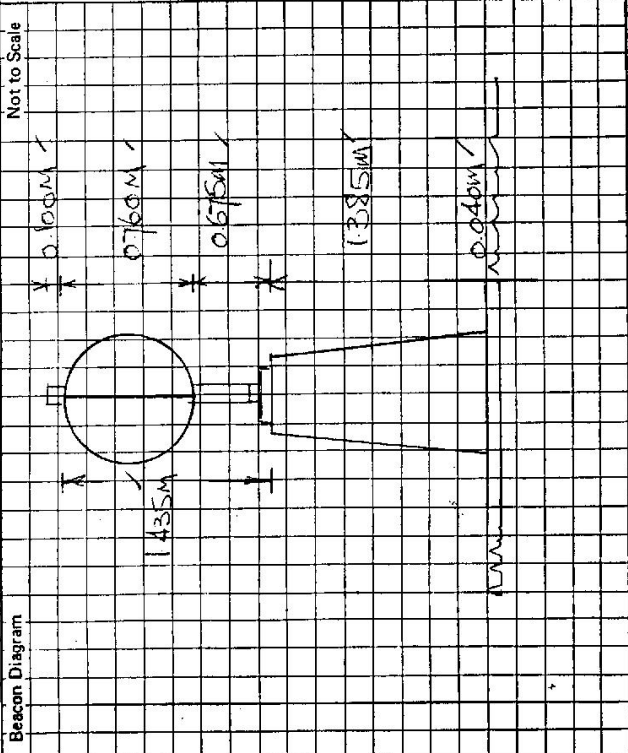

This section to be completed by officer constructing pillar.

Original station mark found/not found.

Description of mark: .....

Original beacon found/not found.

Description of beacon: .....

Height Top of Vanes to Top Mark.....m.

Height of mark.....m. above G.L. below

Diameter of Vanes .....m.

Original Beacon has/has not been destroyed by me.

Date	Record of Station

CENTRAL MAPPING AUTHORITY

GEODETTIC SURVEY OF N.S.W.

GEODETTIC STATION RECONNAISSANCE and MAINTENANCE REPORT

Description:

1. Cleared by lanes bearing 360° *Note: Cross out word or words which do not apply*
2. Mast & Vanes have been painted white & black respectively. ✓
3. The station/pillar was unpiled/not unpiled/constructed on 19....., dimensions now being:  
Description of mark 19..... should be explicit, e.g., S/Steel Pillar Plate, Steel plug, Brass plug, Bolt, G.I. Pipe  
Height of mark 1.385.....m. <sup>above</sup> 1.425.....m. <sup>above</sup> G.L. <sub>below</sub> 1.385.....m.  
Height of Top Vanes to Top Mark/Pillar plate 1.435.....m. Diameter of Vanes (vertical) 0.755.....m.  
Height of Cairn.....m. Diameter of Cairn.....m. Name Plate found/~~not found~~/placed.  
Length of Mast.....m. (approximate if not unpiled)
4. A..... set in conc/rock has been placed/found, bearing.....° M from Mast/Plug/Pillar
5. A..... set in conc/rock has been placed/found, bearing.....° M from Mast/Plug/Pillar
6. A..... set in conc/rock has been placed/found, bearing.....° M from Mast/Plug/Pillar
7. A..... set in conc/rock has been placed/found, bearing.....° M from Mast/Plug/Pillar

8. Action required: NEW MARK.....

STANDPOINT:

Mark	Direction	Horiz. Distance	Height Difference	Mark	Direction	Horiz. Distance	Height Difference
			above standpt				above standpt
			below				below
			above standpt				above standpt
			below				below
Prepared by: [Signature]

Checked: [Signature]

Noted on U.T.M. Card

Checked

STATION: GEORGIE C.S.(P) TS No.: 2171  
 MAP SHEETS SCALE 1:250 000 0.0.0.0 SCALE 1:100 000  
 INSPECTED BY: L. HITCHINS DATE: 26.2.88  
 AUTHORITY: C.M.A. FIELD BOOK:

GS 24

<p>STATION</p> <p style="text-align: center; font-weight: bold;">GEORIE G.S.(P) IS 2171</p>	<p>Owner's Name: <u>TOIC RESERVE</u></p> <p>Address: <u>16060</u></p> <p>Current Occupant: <u>MR O S MORLEY</u></p> <p>Address: <u>'BALD HILL'</u></p> <p>Phone: <u>03000 180</u></p> <p>Current Occupant: <u>CAROLINE</u></p> <p>Address: <u>28585</u></p> <p>Phone: <u>088 871 327</u></p> <p style="text-align: center;"><u>ACCESS</u></p> <p>Access Report of <u>26/11/1988</u> was found suitable/unsuitable.</p> <p>P.O. GEORIE HEAD WEST</p> <p>0.43 TURN LEFT OFF BITUMEN. FOLLOW GRAVEL ROAD</p> <p>1.24 PASS GRAVEL ROAD ON RIGHT</p> <p>1.78 TURN LEFT SIGN 'BALD HILL'</p> <p>2.37 MR MORLEYS HOUSE ON RIGHT DOUBLE IRON GATE</p> <p>2.40 TURN VEER LEFT THROUGH WHITE FENCE FOLLOW THIS FENCE</p> <p>TO IRON GATE AT END OF Paddock</p> <p>2.88 IRON GATE NEXT TO KURRATONA TREE</p> <p>3.33 FROM HERE MAKE OWN WAY UP FAIRLY STEEP HILL TO TRIC GEORIE G.S.(P)</p>
<p>Beacon Diagram</p>	<p>Date</p> <p>Record of Station</p>
<p>This section to be completed by officer constructing pillar.</p> <p>Original station mark found/not found.</p> <p>Description of mark: .....</p> <p>Original beacon found/not found.</p> <p>Description of beacon: .....</p> <p>Height Top of Vanes to Top Mark .....m.</p> <p>Height of mark .....m. above rock/conc .....m. below</p> <p>Diameter of Vanes .....m. Height of Cairn .....m.</p> <p>Original Beacon has/has not been destroyed by me.</p>	