

CENTRAL MAPPING AUTHORITY

GEODETIC SURVEY OF NSW
 GEODETIC STATION RECONNAISSANCE and MAINTENANCE REPORT

STATION: **GHOST G.S** No.: **2173**


MAP SHEET SCALE 1:250 000 **NARROMINE**

INSPECTED BY: **R. COOK** DATE: **SEPT 1978**

AUTHORITY: **C.M.A.** FIELD BOOK:

Description: *Note: Cross out word or words which do not apply*

1. Cleared by lances bearing..... from Trig. Mast
2. Mast & Vanes have been painted white & black respectively.
3. The station/pillar ~~was erected~~/not unplied/constructed on.....19....., dimensions now being:
 Description of mark.....*C.L.D.*.....should be explicit. e.g., S/Steel Pillar Plate, Steel plug, Brass plug, Bolt, G.I. Pipe
 Height of mark.....*2.75*.....m. above rock/concrete; Mark is.....*below*.....m. above G.L.
 Height of Top Vanes to Top Mark/Pillar plate.....m. Diameter of Vanes (vertical).....*0.75*.....m.
 Height of Cairn.....*2.0*.....m. Diameter of Cairn.....*2.1*.....m. Name Plate found/not found/placed.
 Length of Mast.....*3.75*.....m. (approximate if not unplied)
4. A.....set in conc/rock has been placed/found, bearing.....° M from Mast/Plug/Pillar
5. A.....set in conc/rock has been placed/found, bearing.....° M from Mast/Plug/Pillar
6. A.....set in conc/rock has been placed/found, bearing.....° M from Mast/Plug/Pillar
7. A.....set in conc/rock has been placed/found, bearing.....° M from Mast/Plug/Pillar
8. Action required: *Good condition. 1/2 Day clearing needed. Suitable for pillars*

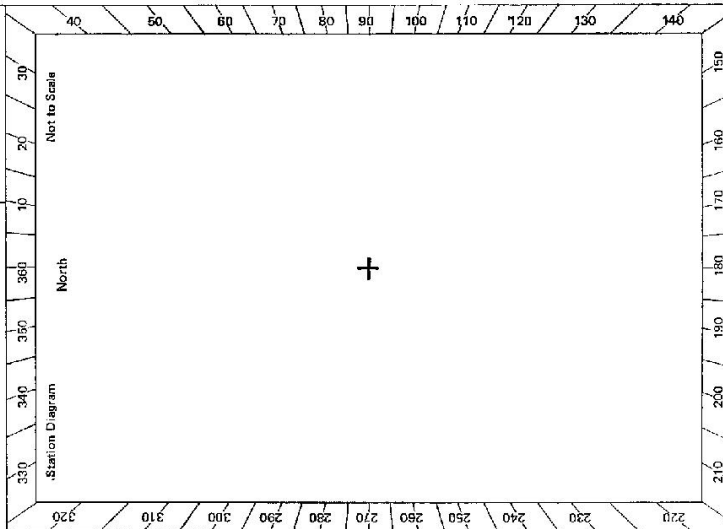

STANDPOINT:

| Mark | Direction | Horiz. Distance | Height Difference | Mark | Direction | Horiz. Distance | Height Difference |
|------|-----------|-----------------|-------------------|------|-----------|-----------------|-------------------|
| | | | above below | | | | above below |
| | | | above below | | | | above below |
Prepared by: **R. COOK** Checked: *[Signature]* Noted on U.T.M. Card

