

CENTRAL MAPPING AUTHORITY

GEODETIC STATION RECONNAISSANCE and MAINTENANCE REPORT

Description: *Notes: Cross out word or words which do not apply*

- Cleared by lanes bearing..... from Trig. Mast
- Mast & Vanes have been painted white & black respectively.
- The station/pillar was unpiled/not unpiled/constructed on.....19....., dimensions now being: Description of mark..... should be explicit, e.g. S/Steel Pillar Plate, Steel plug, Brass plug, Bolt, G.I. Pipe  
 Height of mark.....<sup>above</sup>.....<sub>below</sub>.....m. G.L.  
 Height of Top Vanes to Top Mark/Pillar plate.....m. Diameter of Vanes (vertical).....m.  
 Height of Cairn.....m. Diameter of Cairn.....m. Name Plate found/not found/placed.  
 Length of Mast.....m. (approximate if not unpiled)
- A..... set in conc/rock has been placed/found, bearing.....° M from Mast/Plug/Pillar
- A..... set in conc/rock has been placed/found, bearing.....° M from Mast/Plug/Pillar
- A..... set in conc/rock has been placed/found, bearing.....° M from Mast/Plug/Pillar
- A..... set in conc/rock has been placed/found, bearing.....° M from Mast/Plug/Pillar
- Action required.....

STANDPOINT:			
Mark	Direction	Horiz. Distance	Height Difference
			above standpt.
			below standpt.
			above standpt.
			below standpt.
Prepared by: *[Signature]* 13/8/80 Checked: *[Signature]*

Noted on L.T.M. Card

SI 2733-1

STATION: *GIDGINBUNG GS* No: *2185*  
 MAP SHEET SCALE 1:250 000  
 INSPECTED BY: *P.L. MORGAN* DATE: *11/8/80*  
 AUTHORITY: *C.M.A* FIELD BOOK: *1582*

Station Diagram  
 North  
 Not to Scale  
 TRIG PD IN GOOD CONDITION (MAST REMAINS)  
 WILL BE EASY TO LAUNCH (SLOWLY TO MARK)  
 1/6 OTHER MARKS FD  
 BESSIRIC TO PILLAR MILL

STATION **GIDGINBUNG GS 2185 GS 24**


Owner's Name: **DR + VI SCHMIDT**  
 Address: **LILYDALE GIDGINBUNG**  
 Phone:

Current Occupant: **?**  
 Address: **DR + VI SCHMIDT LILYDALE**  
 Phone:

**ACCESS**

Access Report of **11.8.19** was found suitable/unsuitable.  
**0.00** AT INTERSECTION IN GIDGINBUNG. SIGN TOWARD BARMEDMAN 22 TAKE RD TOWARD BARMEDMAN (AT PM 4440S) PASSING SILOES ON LEFT.  
**0.70** TURN LEFT INTO "LILYDALE" "DR + VI SCHMIDT" + CROSS RAILWAYS RAMP  
**1.20** FOLLOW TRACK BETWEEN HOUSE (COULDERS?) + SHED THAN AROUND TO THE RIGHT  
**1.30** THROUGH DOUBLE IRON GATE FOLLOW ROAD STRAIGHT AHEAD  
**1.80** TURN RIGHT OFF RD AND MAKE OWN WAY ALONG ROCKY RIDGE  
**2.00** IN N.W DIRECTION TO TRIG ABT 0.5km.

Beacon Diagram Not to Scale

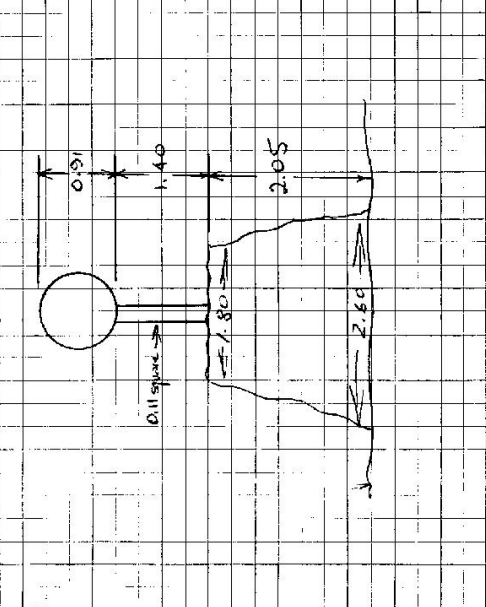

This section to be completed by officer constructing pillar.

Original station mark found/not found.

Description of mark: .....

Original beacon found/not found.

Description of beacon: .....

Height Top of Vanes to Top Mark.....m.

Height of mark.....m. above G.L. below

Diameter of Vanes .....m. Height of Cairn .....m.

Original Beacon has/has not been destroyed by me.

Date	Record of Station

GEODETIC SURVEY OF N.S.W.

CENTRAL MAPPING AUTHORITY

GEODETIC STATION RECONNAISSANCE and MAINTENANCE REPORT

Description:

1. Cleared by lanes bearing..... *Note: Cross out word or words which do not apply*..... from Trig. Mast

2. Mast & Vanes have been painted white & black respectively.

3. The station/pillar was unpiled/~~replaced~~ on 28.7.84..... 19....., dimensions now being:

Description of mark..... should be explicit, e.g., S/Steel Pillar Plate, Steel plug, Brass plug, Bolt, G.I. Pipe

Height of mark.....m. above below rock/concrete; Mark is.....m. above G.L.

Height of Top Vanes to Top Mark/Pillar plate.....m. Diameter of Vanes (vertical).....m.

Height of Cairn.....m. Diameter of Cairn.....m. Name Plate found/not found/placed.

Length of Mast.....m. (approximate if not unpiled)

4. A..... set in conc/rock has been placed/found, bearing.....°M from Mast/Plug/Pillar

5. A..... set in conc/rock has been placed/found, bearing.....°M from Mast/Plug/Pillar

6. A..... set in conc/rock has been placed/found, bearing.....°M from Mast/Plug/Pillar

7. A..... set in conc/rock has been placed/found, bearing.....°M from Mast/Plug/Pillar

8. Action required:.....

STANDPOINT:

STANDPOINT:

Mark	Direction	Horiz. Distance	Height Difference	Mark	Direction	Horiz. Distance	Height Difference
			above standpt				above standpt
			below				below
			above standpt				above standpt
			below				below
Prepared by: *W. G. G. 157 SE* Checked: *7/5/84*

Noted on U.T.M. Card

Checked

STATION: GIDHINBURG G.S. No.: 2185

MAP SHEETS COOLAMUNDRA SCALE 1:250 000

INSPECTED BY: R A HOLLAND DATE: 28.7.84

AUTHORITY: ASSOCIATED SURVEYS PTY LTD FIELD BOOK:

Station Diagram

Not to Scale

Mast rotted - vanes on ground.  
Cairn unpiled, eccentric mark placed.  
No details of marks found or placed given - not cleared.  
Cairn not repiled.