

GEODETTIC SURVEY OF M.S.W.

CENTRAL MAPPING AUTHORITY


GEODETTIC STATION RECONNAISSANCE and MAINTENANCE REPORT

STATION: **GILLENBINE** No.: **2194**

MAP SHEET
SCALE 1:250 000 **NEPTOMINIE**

INSPECTED BY: **P.K. FARMALIA** DATE: **23/9/78**

AUTHORITY: **C.M.A.** FIELD BOOK:

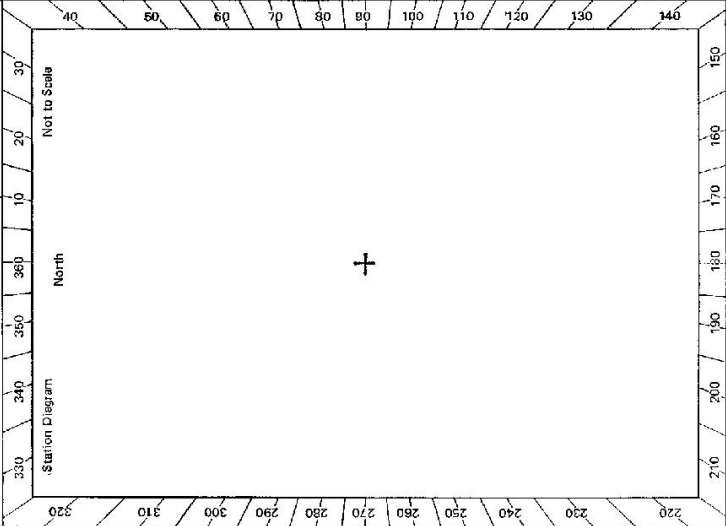

- Description:
1. ~~Created by faxes bearing~~..... Note: Cross out word or words which do not apply
 2. ~~Mast & Vanes have been painted white & black respectively.~~
 3. The station/~~pillar~~ was ~~unplaced~~/not unplaced/~~constructed on~~..... 19....., dimensions now being:
- Description of mark..... should be explicit, e.g., S/Steel Pillar Plate, Steel plug, Brass plug, Bolt, G.I. Pipe
- Height of mark..... m. ^{above} ~~below~~ rock/concrete; Mark is m. ^{above} ~~below~~ G.L.
- Height of Top Vanes to Top Mark/Pillar plate m. Diameter of Vanes (vertical)..... m.
- Height of Cairn..... m. Diameter of Cairn..... m. Name Plate ~~found~~/not found/~~placed~~.
- Length of Mast..... m. (approximate if not supplied)
4. ~~A~~..... set in cone/rock has been placed/~~found~~, bearing..... M from Mast/Plug/Pillar
 5. ~~A~~..... set in cone/rock has been placed/~~found~~, bearing..... M from Mast/Plug/Pillar
 6. ~~A~~..... set in cone/rock has been placed/~~found~~, bearing..... M from Mast/Plug/Pillar
 7. ~~A~~..... set in cone/rock has been placed/~~found~~, bearing..... M from Mast/Plug/Pillar

8. Action required: *Mast and vanes (now removed from station) needs to be replaced. Station needs approx 3 days clearing*

Mark	Direction	Horiz. Distance	Height Difference	Mark	Direction	Horiz. Distance	Height Difference
			above standpt.				above standpt.
			below standpt.				below standpt.
			above standpt.				above standpt.
			below standpt.				below standpt.
STANDPOINT: *Noted on U.T.M. Card*

Prepared by: *Arumud. 20/9/78* Checked: *Checked*

