

GEODETTIC SURVEY OF N.S.W.

CENTRAL MAPPING AUTHORITY


GEODETTIC STATION RECONNAISSANCE and MAINTENANCE REPORT

STATION: **GLASGOW** No.: **2204**

MAP SHEET SCALE 1:250 000 **CANBERRA**

INSPECTED BY: **G. C. HANNA** DATE: **23/4/79**

AUTHORITY: **C.M.A.** FIELD BOOK:

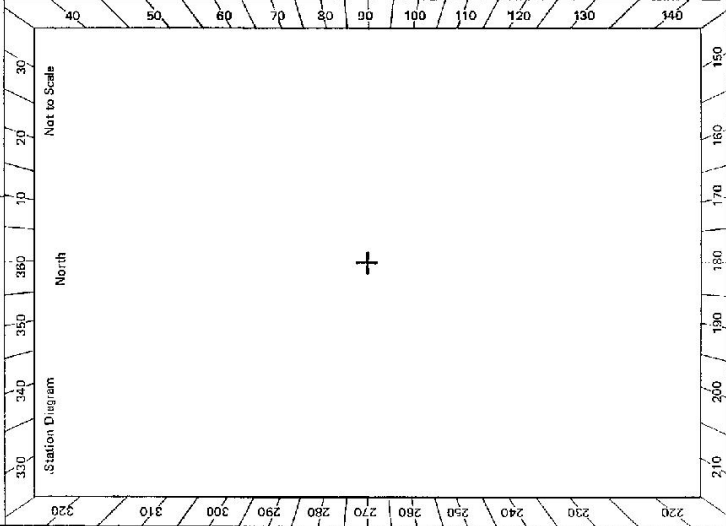

- Description:
- Note: Cross out word or words which do not apply*
- Cleared by lanes bearing..... from Trig. Mast
 - Mast & Vanes have been painted white & black respectively.
 - The station/pillar was unpiled/not unpiled/constructed on..... 19..... dimensions now being:
Description of mark..... should be explicit, e.g., S/Steel Pillar Plate, Steel plug, Brass plug, Bolt, G.I. Pipe
Height of mark..... m. ^{above} _{below} rock/concrete; Mark is..... m. ^{above} _{below} G.L.
 - Height of Top Vanes to Top Mark/Pillar plate..... m. Diameter of Vanes (vertical)..... m.
Height of Cairn..... m. Diameter of Cairn..... m. Name Plate found/not found/placed.
Length of Mast..... m. (approximate if not unpiled)
 - A..... set in conc/rock has been placed/found, bearing..... ° M from Mast/Plug/Pillar
 - A..... set in conc/rock has been placed/found, bearing..... ° M from Mast/Plug/Pillar
 - A..... set in conc/rock has been placed/found, bearing..... ° M from Mast/Plug/Pillar
 - A..... set in conc/rock has been placed/found, bearing..... ° M from Mast/Plug/Pillar
 - Action required:.....

STANDPOINT:

| Mark | Direction | Horiz. Distance | Height Difference | Mark | Direction | Horiz. Distance | Height Difference |
|------|-----------|-----------------|-------------------|------|-----------|-----------------|-------------------|
| | | | above standpt. | | | | above standpt. |
| | | | below | | | | below |
| | | | above standpt. | | | | above standpt. |
| | | | below | | | | below |
Prepared by: *G. Hanna 8/5/79* Checked: *[Signature]* Noted on U.T.M. Card

| | | | | | |
|--|------------------------------------|--|---|-------------------|---|
| 81.2793--2 D. West, Government Printer Beacon Diagram Not to Scale | STATION GLASSGOW TS 2204 | Owner's Name: Address: Phone: Current Occupant: Address: Phone: | ACCESS Access Report of 13.4.19.11 was found suitable/unsuitable. Cairn found. 5 minute walk Several medium trees block 360° vision. | | For further information see Manar 8827- III-N |
| This section to be completed by officer constructing pillar. Original station mark found/not found. | | Description of mark: Original beacon found/not found. | | | |
| Description of beacon: Height Top of Varies to Top Mark.....m. Height of mark.....m. above rock/conc.....m. above G.L. Diameter of Vases.....m. Height of Cairn.....m. Original Beacon has/has not been destroyed by me. | | Date | | Record of Station | |