

Department of Lands

RECONNAISSANCE and MAINTENANCE REPORT

STATION TS 2215 GLENFIELD

This Trig. Station has been:

Note: Cross out word or words which do not apply

- 1. Completely cleared to permit 360° vision to surrounding Trigs.
- 2. Cleared by lanes bearing..... from Trig. Mast
- 3. Trig. Mast & Vanes have been painted white & black respectively.
- 4. The Trig. was unpiled/~~not unpiled~~, dimensions now being:

Description of mark. BRASS PLUG IN RM BOX should be explicit, e.g. Steel plug, Brass plug, Bolt, Concrete Pillar

Height of mark..... m above rock/concrete..... m above below G.L.

Height of Top Vanes to Top Mark/Top pillar plate..... m Diameter of Vanes (vertical)..... m.

Height of Cairn..... m. Diameter of Cairn..... m.

Length of Mast..... m. (approximate if not unpiled)

- 5. A. SSM set in conc/reck has been placed/d. 4.618 m. bearing. 305°M from Trig. Mast/pillar PLUG
- 6. A. GA PIPE set in conc/soil has been placed/d. 4.354 m. bearing. 250°M from Trig. Mast/pillar PLUG
- 7. A..... set in conc/soil has been placed/d..... m. bearing.....°M from Trig. Mast/pillar
- 8. A..... set in conc/rock has been placed/d..... m. bearing.....°M from Trig. Mast/pillar

9. Connection. SSM to GA PIPE: 4.143 m. bearing. 186°M

10. Connection..... to..... m. bearing.....°M

11. Connection..... to..... m. bearing.....°M

12. Connection..... to..... m. bearing.....°M

13. Diff. Ht. SSM is 0.028 m. above TRIG PLUG below

14. Diff. Ht. GA PIPE is 0.136 m. above TRIG PLUG below

15. Diff. Ht. is..... m. above below

16. Diff. Ht. is..... m. above below

Prepared by: C. Smevett Checked: [Signature]

Car: CARP (REMOVED) PH: 50 11 11 11

Map Sheet: LEPPINGTON 610000 No: 8237

Inspected by: C. STARKLEY Date: 30.7.79

Authority: LANDS DEPT Field Book: 1A03

Beacon Diagram

Not to Scale

Date

Record of Station

Non-Geometric

STATION TS 2215 GLENFIELD

Current Occupant.....


Address.....

Owners Name.....

Address.....


Access.....

Station Diagram Not to Scale

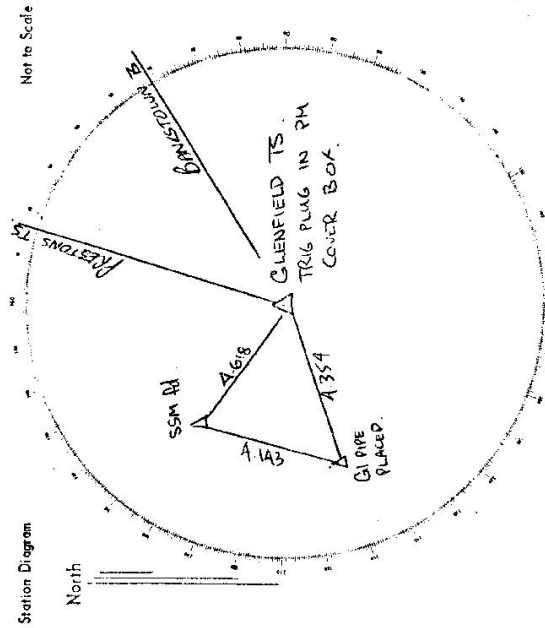

List of Observed Directions:-

Station	Direction	Station	Direction
TRIG PLUG	0.00 0.00	TRIG PLUG	59 20.36
SSM PLUG	13.04 31.7		
BONGLOWN TS	55 42.06.0		
PIPE PLACED	250.11 37.9		
SSM PLUG	305.05 15.4		
Station	Direction	Station	Direction

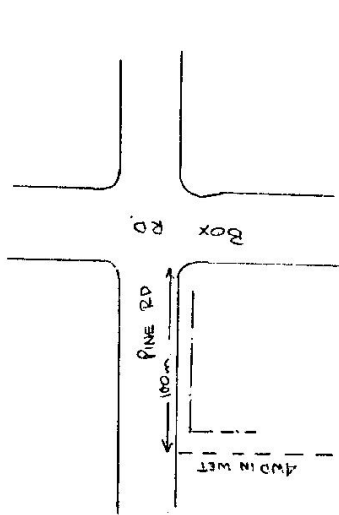




D. West, Government Printer, New South Wales - 1974



TS2215

STATION TS 2215 GLENFIELD

Owners Name... Adam Current Occupant.....
 Address... 0418 607860 Address.....
 Access 30-7-1979 13-7-2011 P. S. J. H. A. G. L. D.

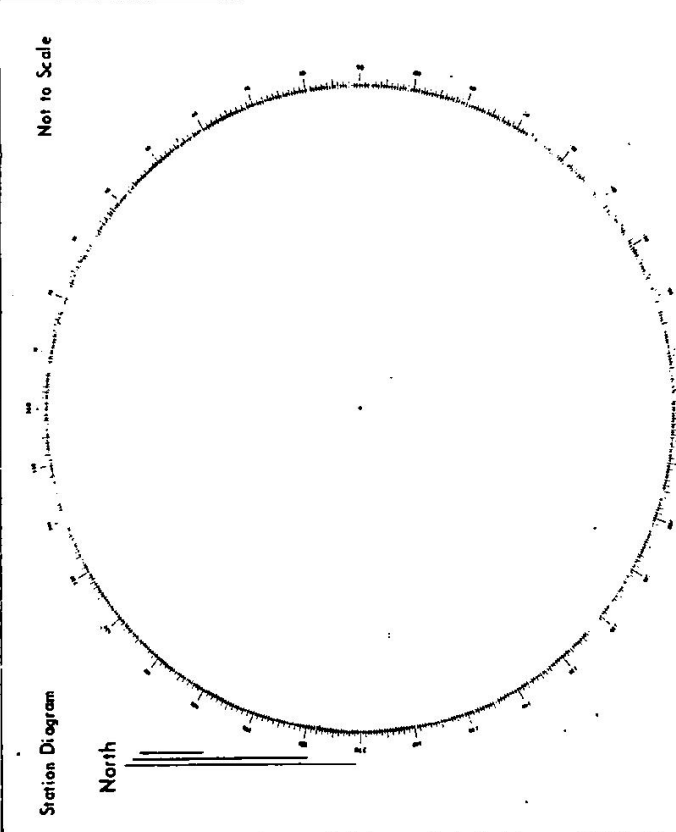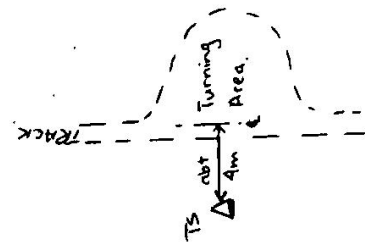
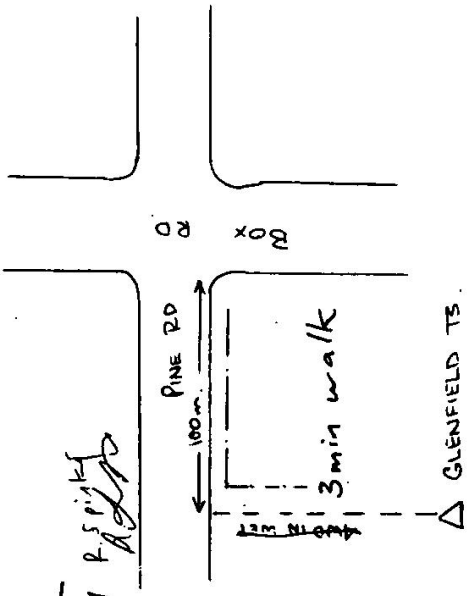


List of Observed Directions:-


Standpoint:		Standpoint:	
Station	Direction	Station	Direction

STATION TS 2215 GLENFIELD

Owners Name.....
 Current Occupant.....
 Address.....
 Address.....

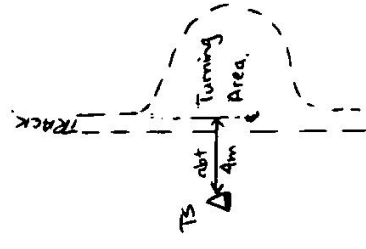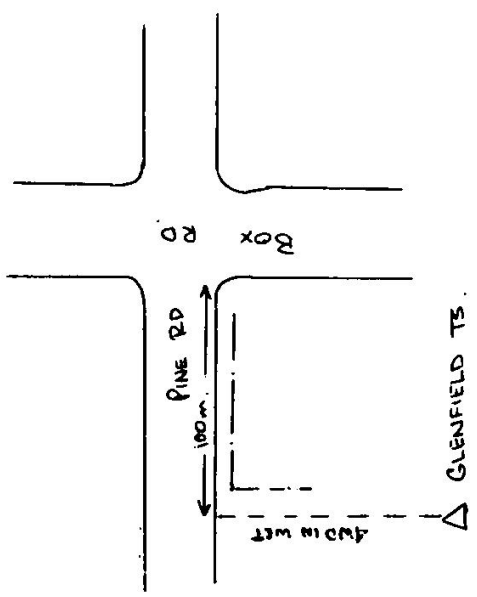

Not to Scale

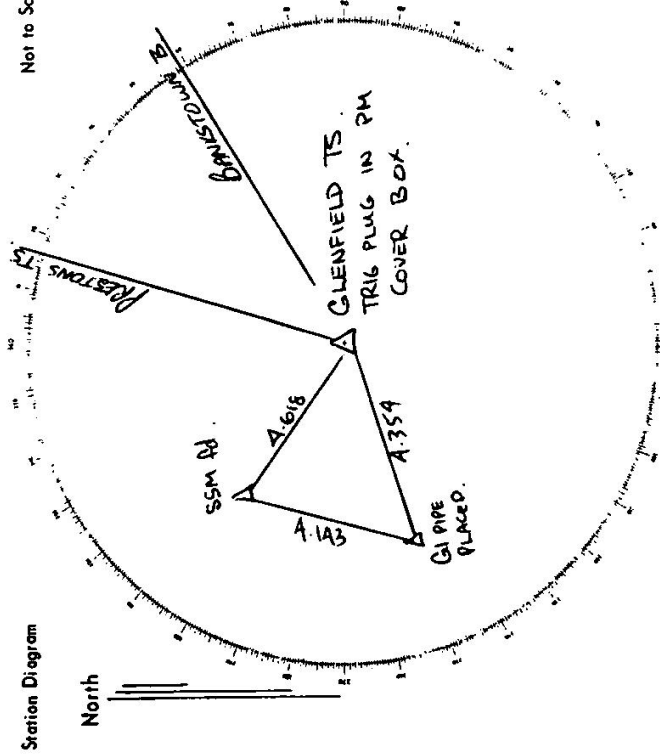

List of Observed Directions:-

Standpoint: TRIG AUG Standpoint: SSM

Station	Direction	Station	Direction
PRESTONS TS	18 04 31.7	TRIG PLUG	0° 00 00
BRANKSTOWN TS	59 42 06.0	GI P	59 20.36
GI P PLACED	250 11 37.9		
SSM FOUND	305 05 15.4		