

GEODETTIC SURVEY OF N.S.W.

CENTRAL MAPPING AUTHORITY


GEODETTIC STATION RECONNAISSANCE and MAINTENANCE REPORT

STATION: *Gobondry* No.: *2237*

MAP SHEET SCALE 1:250 000 *Narramine*

INSPECTED BY: *P. K. Bamole* DATE: *29/9/78*

AUTHORITY: *C.M.A.* FIELD BOOK:

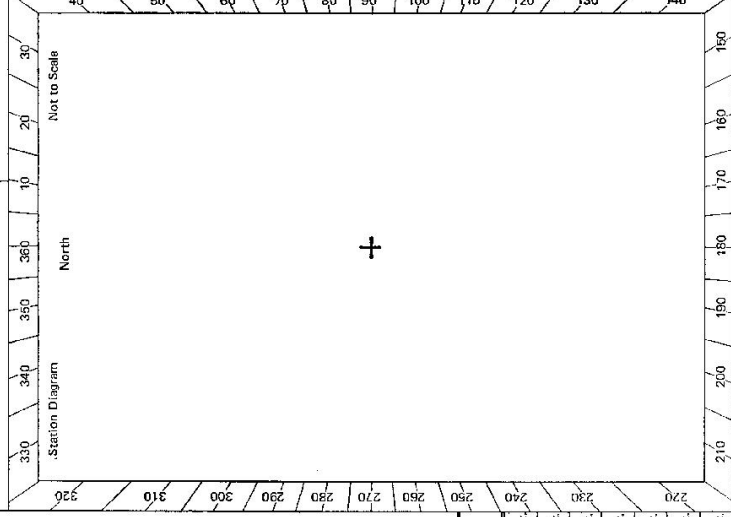

- Description:
1. ~~Greened-by-lanes-bearing-~~ *found* ~~from Fig. Mast.~~  
Note: *Cross out word or words which do not apply*
  2. Mast & Vanes have been painted white & black respectively.
  3. The station/~~pillar~~ *found* was unplaced/not unplaced/constructed on *19* dimensions now being: *19* should be explicit, e.g., *Steel-Pillar Plate, Steel plug, Brass plug, Bolt, G.I. Pipe*
  - Description of mark: *above* *below* *rock/concrete* Mark is *above* *below* *G.I.L.*
  - Height of mark *above* *below* *rock/concrete* m. Mark is *above* *below* *G.I.L.* m.
  - Height of Top Vanes to Top Mark/Pillar plate *above* *below* *rock/concrete* m. Diameter of Vanes (vertical) *above* *below* *G.I.L.* m.
  - Height of Cairn *above* *below* *rock/concrete* m. Diameter of Cairn *above* *below* *G.I.L.* m. Name Plate found/not found/placed.
  - Length of Mast *above* *below* *rock/concrete* m. (approximate if not unplaced)
  4. A *above* *below* *rock/concrete* set in conc/rock has been placed/found, bearing *above* *below* *rock/concrete* ° M from Mast/Plug/Pillar
  5. A *above* *below* *rock/concrete* set in conc/rock has been placed/found, bearing *above* *below* *rock/concrete* ° M from Mast/Plug/Pillar
  6. A *above* *below* *rock/concrete* set in conc/rock has been placed/found, bearing *above* *below* *rock/concrete* ° M from Mast/Plug/Pillar
  7. A *above* *below* *rock/concrete* set in conc/rock has been placed/found, bearing *above* *below* *rock/concrete* ° M from Mast/Plug/Pillar
  8. Action required: *An oblonging pillar with brass spigot, is situated approx 3m South of the station. Approximately 3 days clearing required*


STANDPOINT:

Mark	Direction	Horiz. Distance	Height Difference	Mark	Direction	Horiz. Distance	Height Difference
			above standpt.				above standpt.
			below standpt.				below standpt.
			above standpt.				above standpt.
			below standpt.				below standpt.
			above standpt.				above standpt.
			below standpt.				below standpt.
			above standpt.				above standpt.
			below standpt.				below standpt.

Prepared by: *Sutherland 24/9/78* Checked: *Sutherland* Noted on U.T.M. Card



ST 2237-2 D. West. Government Printer

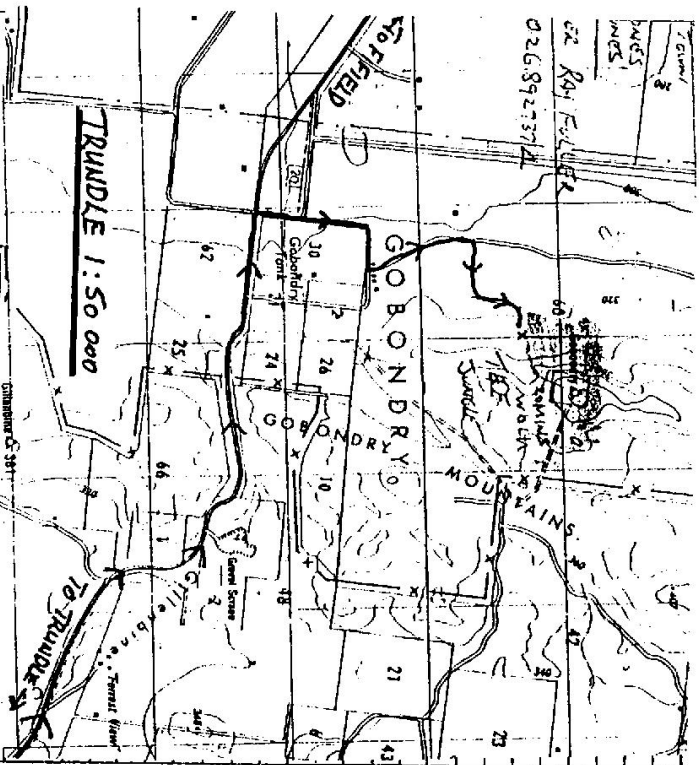

Original station mark found/not found.  
 Description of mark: .....  
 Original beacon found/not found.  
 Description of beacon: .....  
 Height Top of Vanes to Top Mark.....m.  
 Height of mark.....m. above rock/stone.....m. above G.L.  
 below  
 Diameter of Vanes.....m. Height of Cairn.....m.  
 Original Beacon has/has not been destroyed by me.

STATION **GOBONDRY TS 2237**

Owner's Name: **CARMY JONES**  
 Address: **TRUNDLE**  
**CONTACT MANAGER LINES**  
 OR **PLANNING**  
 Phone: .....

MANAGER. **RAY FULLER.**  
 Current Occupant:  
 Address: **FIELD ROAD**  
**VIA TRUNDLE**  
 Phone: **68927374**

Access Report of ...../19.....was found suitable/unsuitable.

**2237 Gobondry TS**

- 0.00 cal 25.3 Trundle pub head north
- 8.75 16.55 Take gravel road to left (Field 21)
- 16.80 8.50 Pass Hillsdale on left
- 17.65 7.65 Pass Forrest View Mail Box on RHS
- 22.20 3.10 Turn right at cross roads
- 22.60 2.70 Gates
- 23.10 2.20 Right through gate
- 23.40 1.90 Left towards machinery shed keeping it on your left then veer left to gate in corner behind house
- 23.60 1.70 Gate follow track which runs diagonal across the paddock
- 24.10 1.20 Gate follow track right up along fence (trig on northern peak)
- 24.50 0.80 Left along fence
- 24.95 0.35 Right through gate follow faint track up hill timber on your right
- 25.20 0.10 Left around small pine towards trig hill
- 25.30 0.00 Park truck edge of timber and walk NE to northern peak

(Abt 30 mins drive from Trundle, then 20 mins walk to trig)

Date

Record of Station

INSPECTED BY: **G. FORD** DATE: **20-9-99**

*Cleared for C.P.S.*  
*NEEDS NEW MAST AND CABLE REMOVED [84508 TO RENEW]*