

CENTRAL MAPPING AUTHORITY

GEODETTIC SURVEY OF NS/SK

GEODETTIC STATION RECONNAISSANCE and MAINTENANCE REPORT

Description:

Note: Cross out word or words which do not apply

1. Cleared by lanes bearing $100^{\circ}M$, $135^{\circ}M$, $333^{\circ}M$, $340^{\circ}M$, $262^{\circ}M$, $270^{\circ}M$ from Trig. Mast

2. Mast & Vanes have been painted white & black respectively. Repure painting

3. The station/pillar was unpiled/not unpiled/constructed on 19 dimensions now being:

Description of mark should be explicit, e.g., S/Steel Pillar Plate, Steel plug, Brass plug, Bolt, G.I. Pipe

Height of mark m. ^{above}/_{below} rock/concrete; Mark is m. ^{above}/_{below} G.L.

Height of Top Vanes to Top Mark/Pillar plate m. Diameter of Vanes (vertical) 0.14 m.

Height of Cairn m. Diameter of Cairn 3.0 m. Name Plate found/not found/placed.

Length of Mast 3.0 m. (approximate if not unpiled)

No eccentric marks found

4. A set in conc/rock has been placed/found, bearing M from Mast/Plug/Pillar

5. A set in conc/rock has been placed/found, bearing M from Mast/Plug/Pillar

6. A set in conc/rock has been placed/found, bearing M from Mast/Plug/Pillar

7. A set in conc/rock has been placed/found, bearing M from Mast/Plug/Pillar

8. Action required:

STANDPOINT:

STANDPOINT:

Mark	Direction	Horiz. Distance	Height Difference	Mark	Direction	Horiz. Distance	Height Difference
			above standpt				above standpt
			below standpt				below standpt
			above standpt				above standpt
			below standpt				below standpt
Prepared by: P. CARR 12/3/81 Checked: *[Signature]* 5/6/81

Noted on U.T.M. Card

ST 2738-1

6-

STATION: GOGOBILLY G.S. No.: 2241

MAP SHEET SCALE 1:250 000 COOTAMUNDRA

INSPECTED BY: D. HALLS DATE: 5-2-81

AUTHORITY: C.M.A. FIELD BOOK: 1886

Station Diagram

North

+

STATION **GOGOBILLY G.S. TS 2241**


Owner's Name:
 Address:
 Phone:
 Current Occupant:
 Address:
 Phone:

ACCESS

Access Report of 5/2/1981 was found suitable/unsuitable.

Km

- 0-0 COMMERCIAL HOTEL, STOCKINGINAL. Head west towards Temora.
- 3-95 Turn left into Clifford Lane toward Gogobilly.
- 5-10 Grid.
- 6-40 Gate.
- 7-60 Gate.
- 8-40 Through gate, turn left and follow main track.
- 8-95 Gate.
- 10-15 Gate.
- 12-0 Through gate, pass house on right (see owner). Follow track towards hill.
- 12-25 Veer right, by-pass track on left.
- 12-65 Gate, follow track.
- 13-55 AT Gogobilly radio station. Trig on top of small rise 50m ahead.

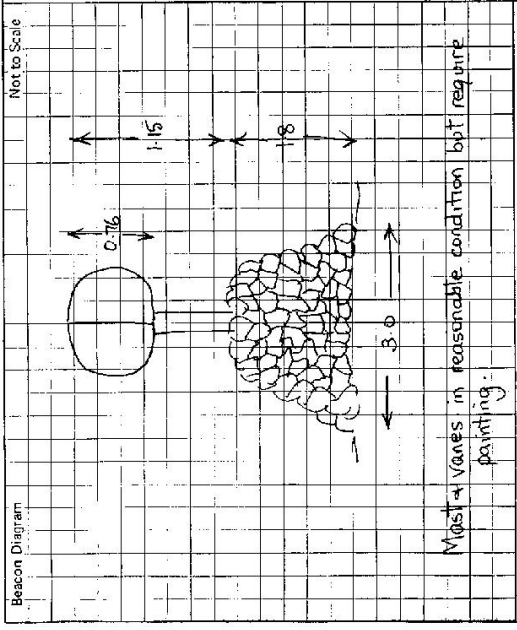

This section to be completed by officer constructing pillar.

Original station mark found/not found.

Description of mark:

Original beacon found/not found.

Description of beacon:

Height Top of Vanes to Top Mark:m.

Height of mark:m. above G.L. below

Diameter of Vanesm. Height of Cairnm.

Original Beacon has/has not been destroyed by me.

Date	Record of Station