




STATION GOLSFILE GS TS 2246

Owner's Name: MR. R. DRABET  
 Address: .....  
 Phone: .....  
 Current Occupant: .....  
 Address: .....  
 Phone: .....

**ACCESS**

Access Report of 11.3.1981 was found suitable/unsuitable.

- 0 LAGGAN POST OFFICE TAKE REDWOOD WITHWIST ROAD
- 3 TURN RIGHT GOLSFILE ROAD.
- 16 CONCRETE BRIDGE
- 19 PASS LEVELS ROAD AND RIGHT.
- 20 TURN RIGHT GRIND DRIVE POST HOUSE. MARK WAY TO GS.
- 21 GS.

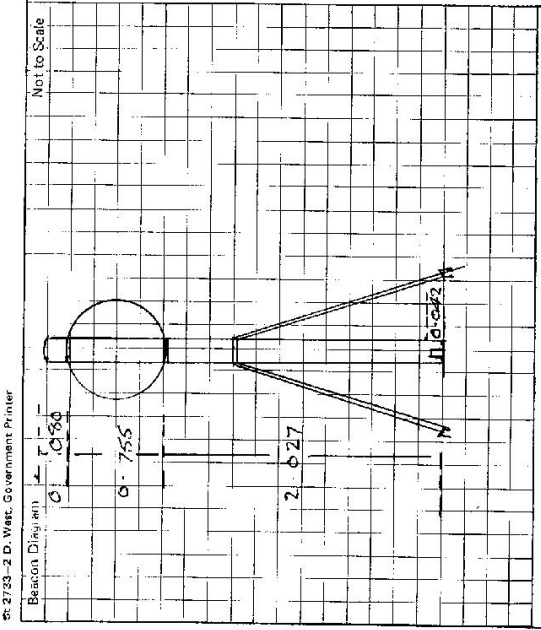

This section to be completed by officer constructing pillar.

Original station mark found/~~not found~~.  
 Description of mark: S/S. P. 11  
 Original beacon ~~found~~/not found.  
 Description of beacon: M.S.T. 4 LAGGAN DISTRICT  
 Height Top of Vanes to Top Mark: .....m.  
 Height of mark: 0.755 above conc .....m. below G.L.  
 Diameter of Vanes: .....m. Height of Cairn: M/C .....m.  
 Original Beacon has ~~been~~ been destroyed by me.

Date	Record of Station