

GEODETTIC SURVEY OF M.S.V.

CENTRAL MAPPING AUTHORITY

GEODETTIC STATION RECONNAISSANCE and MAINTENANCE REPORT

Description:

Note: Cross out word or words which do not apply

1. Cleared by lances bearing..... from Trig. Mast
2. Mast & Vanes have been painted white & black respectively.
3. The station/~~marker~~ was ~~constructed~~/not unplied/constructed on..... 19..... dimensions now being:

Description of mark..... should be explicit, e.g., S/Steel Pillar Plate, Steel plug, Brass plug, Bolt, G.I. Pipe

Height of mark..... m. ^{above}/_{below} rock/concrete; Mark is..... m. ^{above}/_{below} G.I.

Height of Top Vanes to Top Mark/Pillar plate m. Diameter of Vanes (vertical)..... m.

Height of Cairn..... m. Diameter of Cairn...2.3..... m. Name Plate found/not found/placed.

Length of Mast..... 3.1..... m. (approximate if not unplied)
4. A..... set in conc/rock has been placed/ found, bearing..... °M from Mast/Plug/Pillar
5. A..... set in conc/rock has been placed/ found, bearing..... °M from Mast/Plug/Pillar
6. A..... set in conc/rock has been placed/ found, bearing..... °M from Mast/Plug/Pillar
7. A..... set in conc/rock has been placed/ found, bearing..... °M from Mast/Plug/Pillar
8. Action required: No. CLEARANCE NEEDED, IN ROAD CONVICTIONS, DRIVE-THRU ACCESS.

STANDPOINT:

Mark	Direction	Horiz. Distance	Height Difference	Mark	Direction	Horiz. Distance	Height Difference
			above standpt.				above standpt.
			below				below
			above standpt.				above standpt.
			below				below
Prepared by: Rochay Cook Checked: _____

Noted on U.T.M. Card

ST 2783-1

STATION: GOANDRA	No.: 2248
MAP SHEET SCALE: 1:250,000	TANTANGARA I: 100,000
INSPECTED BY: R. COOK	DATE: B-3-79
AUTHORITY: C.M.A.	FIELD BOOK:

Station Diagram


Checked

STATION **GOOANDRA G.S. TS 2248**

Current Occupant:
 Address:
 Phone:

Owner's Name:
 Address: **SITABER MATRIM THE**
KOCSIWKO NATIONAL PARK
 Phone:

ACCESS
 Access Report of **11/1977** was found suitable/.....

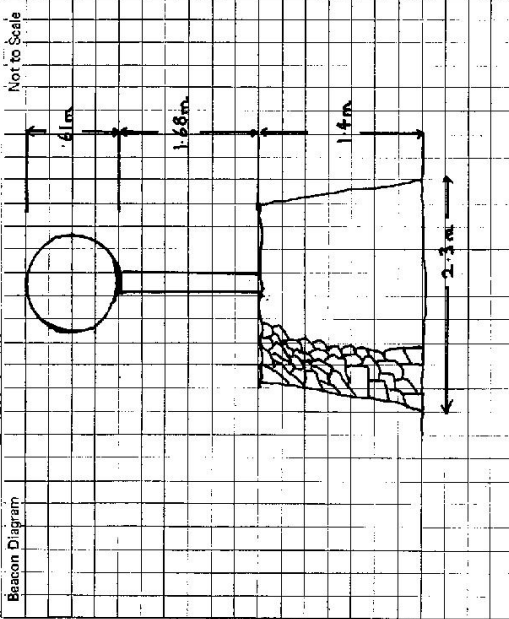

This section to be completed by officer constructing pillar.

Original station mark found/not found.

Description of mark:

Original beacon found/not found.


Description of beacon:

Height Top of Vanes to Top Mark.....m.

Height of mark.....m. above G.L.
 below

Diameter of Vanes.....m. Height of Cairn.....m.

Original Beacon has/has not been destroyed by me.

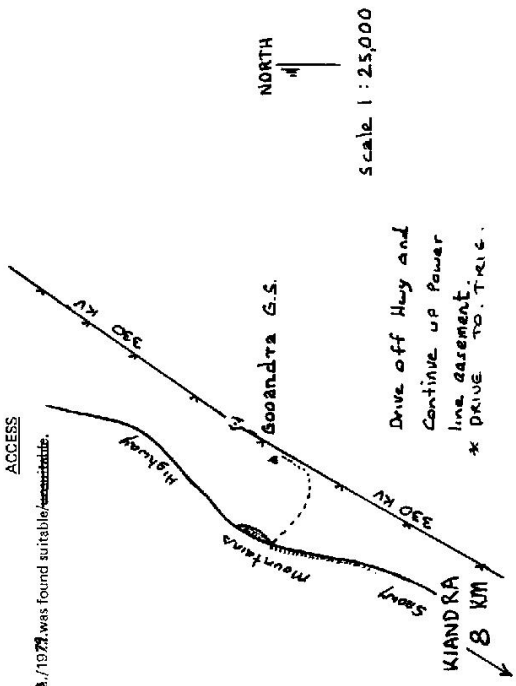

Date	Record of Station
8.3.79	Recommence of T.R.C. During Field Completion of T.R.C. at Gooandra 1:25,000 Access taken off the T.R.C. 1:25,000 Provisional.