

CENTRAL MAPPING AUTHORITY

GEODETIC SURVEY OF N.S.W.


GEODETIC STATION RECONNAISSANCE and MAINTENANCE REPORT

STATION: **GOODRADDIGBEE** No.: **2253**

MAP SHEET SCALE 1:250 000 **CANBERRA**

INSPECTED BY: **W MILLER** DATE: **13.6.78**

AUTHORITY: **CMA** FIELD BOOK:

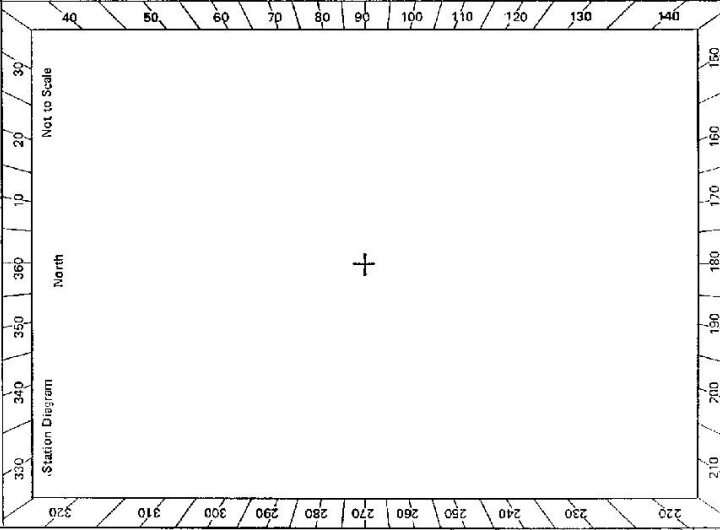

- Description:
- Cleared by lanes bearing. *Note: Cross out word or words which do not apply*
 360° from Trig. Mast.
 - Mast & Vanes have been painted white & black respectively.
 - The station/pillar was unpiled/not unpiled/constructed on.....19..... dimensions now being:
 Description of mark.....should be explicit, e.g., S/Steel Pillar Plate, Steel plug, Brass plug, Bolt, G.I. Pipe
 Height of mark.....m. ^{above}/_{below} rock/concrete; Mark is.....m. ^{above}/_{below} G.L.
 Height of Top Vanes to Top Mark/Pillar platem. Diameter of Vanes (vertical).....m.
 Height of Cairn.....m. Diameter of Cairn.....m. Name Plate found/not found/placed.
 Length of Mastm. (approximate if not unpiled)
 - A.....set in conc/rock has been placed/found, bearing.....°M from Mast/Plug/Pillar
 - A.....set in conc/rock has been placed/found, bearing.....°M from Mast/Plug/Pillar
 - A.....set in conc/rock has been placed/found, bearing.....°M from Mast/Plug/Pillar
 - A.....set in conc/rock has been placed/found, bearing.....°M from Mast/Plug/Pillar
 - Action required:.....

STANDPOINT:			
Mark	Direction	Horiz. Distance	Height Difference
			above standpt
			below standpt
			above standpt
			below standpt
Prepared by:
 Checked:
 Noted on U.T.M. Card

St 2739 - 2 D. West, Government Printer

GS 24

<p>Beacon Diagram</p>	<p>Not to Scale</p>	<p>Date: <u>13-6-78</u></p> <p>Owner's Name: <u>13-6-78</u></p> <p>Address: <u>13-6-78</u></p> <p>Current Occupant: <u>13-6-78</u></p>	
		<p>Date: <u>13-6-78</u></p> <p>Record of Station: <u>Done to no trace base ill</u></p>	
<p>This section to be completed by officer constructing pillar.</p>			
<p>Original station mark found/not found.</p>			
<p>Description of mark:</p>			
<p>Original beacon found/not found.</p>			
<p>Description of beacon:</p>			
<p>Height Top of Vanes to Top Mark:m. <small>above</small> <small>below</small></p>			
<p>Height of mark:m. <small>above</small> <small>below</small> G.L.</p>			
<p>Diameter of Vanes:m. Height of Cairn:m.</p>			
<p>Original Beacon has/has not been destroyed by me.</p>			