

CENTRAL MAPPING AUTHORITY

GEODETIC SURVEY OF N.S.W.

GEODETIC STATION RECONNAISSANCE and MAINTENANCE REPORT

STATION: *GREENSCREE GE.* No.: *2275*

MAP SHEET SCALE 1:250 000 *Dubbo*

INSPECTED BY: *P.H.M.S.* DATE: *27th May 1981*

AUTHORITY: *Col. A.* FIELD BOOK: *1808*

Description:
 1. Cleared by lanes bearing *360°* *Note: Cross out word or words which do not apply* from Trig. Mast

2. Mast & Vanes have been painted white & black respectively. ✓

3. The station/pillar was unpiled/~~reconstructed~~/~~constructed~~ on *27th May 1981*, dimensions now being:

Description of mark *Steel Trig. Pillar* should be explicit, e.g., S/Steel Pillar Plate, Steel plug, Brass plug, Bolt, G.I. Pipe

Height of mark *0.060* m. ^{above} rock/~~concrete~~; Mark is *0.060* m. ^{above} G.L.

Height of Top Vanes to Top Mark/~~Pillar plate~~ *2.560* m. Diameter of Vanes (vertical) *0.785* m.

Height of Cairn *0.850* m. Diameter of Cairn *0.850* m. Name Plate ~~found~~/~~not found~~/~~placed~~.

Length of Mast *0.850* m. (approximate if not unpiled)

4. A *0.850* set in conc./rock has been placed/found, bearing *360°* M from Mast/Plug/Pillar

5. A *0.850* set in conc./rock has been placed/found, bearing *360°* M from Mast/Plug/Pillar

6. A *0.850* set in conc./rock has been placed/found, bearing *360°* M from Mast/Plug/Pillar

7. A *0.850* set in conc./rock has been placed/found, bearing *360°* M from Mast/Plug/Pillar

8. Action required: *Interchangeable. See also previous sheets & take care with*

STANDPOINT:


STANDPOINT:

Mark	Direction	Horiz. Distance	Height Difference	Mark	Direction	Horiz. Distance	Height Difference
			above standpt				above standpt
			below				below
			above standpt				above standpt
			below				below
Prepared by: *P.H.M.S. 29th May 1981* Checked: *P.H.M.S. 18/9/81*

Noted on U.T.M. Card: *P.H.M.S. 18/9/81* Checked

S 2733-1

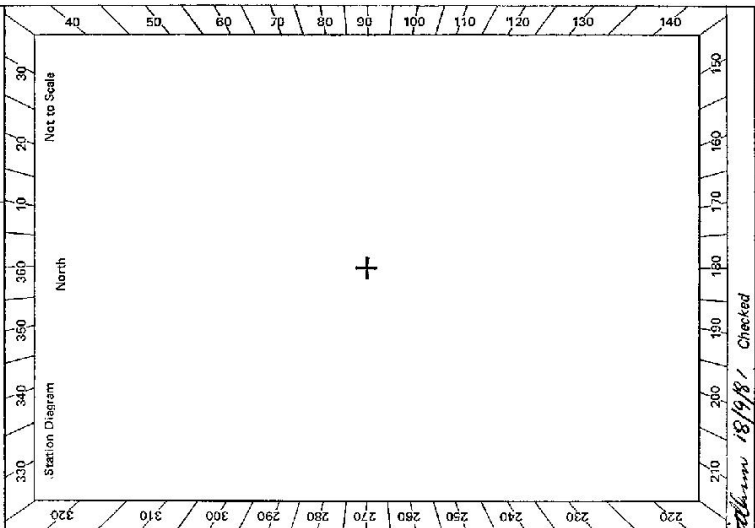


STATION *GORANBOREE AT TS 2275*

Owner's Name: *Mr J Chapman*
 Address:
 Phone:
 Current Occupant:
 Address:
 Phone:

ACCESS

Access Report of 27.5.1981, was found suitable/unsuitable.

AM **ROUTE**
 0.00 TO STURGET TOWN HEAD TOIMARDI ORANGE
 0.25 TURN RIGHT SIGN "WELLSINGTON" & "MUMDIE"
 1.75 TURN LEFT SIGN "CANNVOLA" & "MOLLARD"
 2.30 TAKE LEFT FORK
 2.75 CHAISEWAY
 4.15 GRID
 4.55 GRID
 5.55 GRID
 6.95 TURN RIGHT THROUGH WHITE IRON GATE
 7.00 IRON GATE - HOUSE ON RIGHT
 7.05 IRON GATE
 7.10 TAKE TRACK ON LEFT
 7.20 PASS TRACK ON RIGHT
 7.25 PASS TRACK ON RIGHT
 7.45 PASS GATE ON RIGHT
 7.55 IRON GATE - THEN TURN SHARPLY RIGHT THROUGH IRON GATE THEN LEFT
 7.65 TURN RIGHT
 7.90 TAKE RIGHT FORK
 8.00 TURN LEFT UP RIDGE
 8.25 LEAVE VEHICLE & WALK IN A NORTH-WESTERLY DIRECTION FOR 5 MIN.

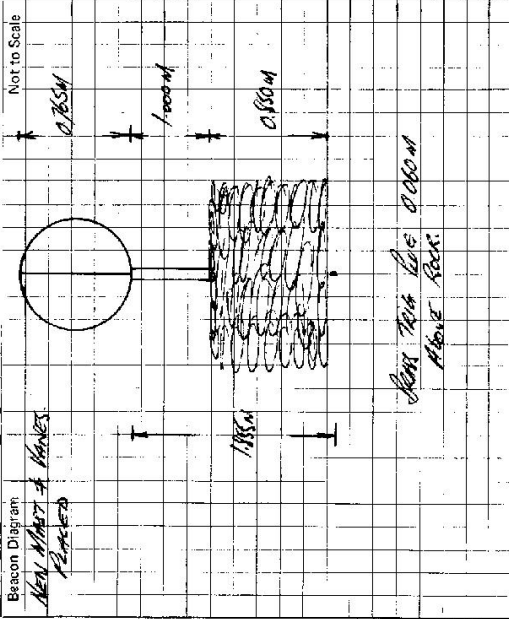

This section to be completed by officer constructing pillar:
 Original station mark found/not found:
 Description of mark:
 Original beacon found/not found:
 Description of beacon:
 Height Top of Vanes to Top Markm.
 Height of markm. above G.L.
 below rock/conc.m. below G.L.
 Diameter of Vanesm. Height of Cairnm.
 Original Beacon has/has not been destroyed by me.

Date	Record of Station