




TS228

TS228 CMA 2-091

Locality : Darlington Point

LGA : Murrumbidgee

## ACCESS DIAGRAM

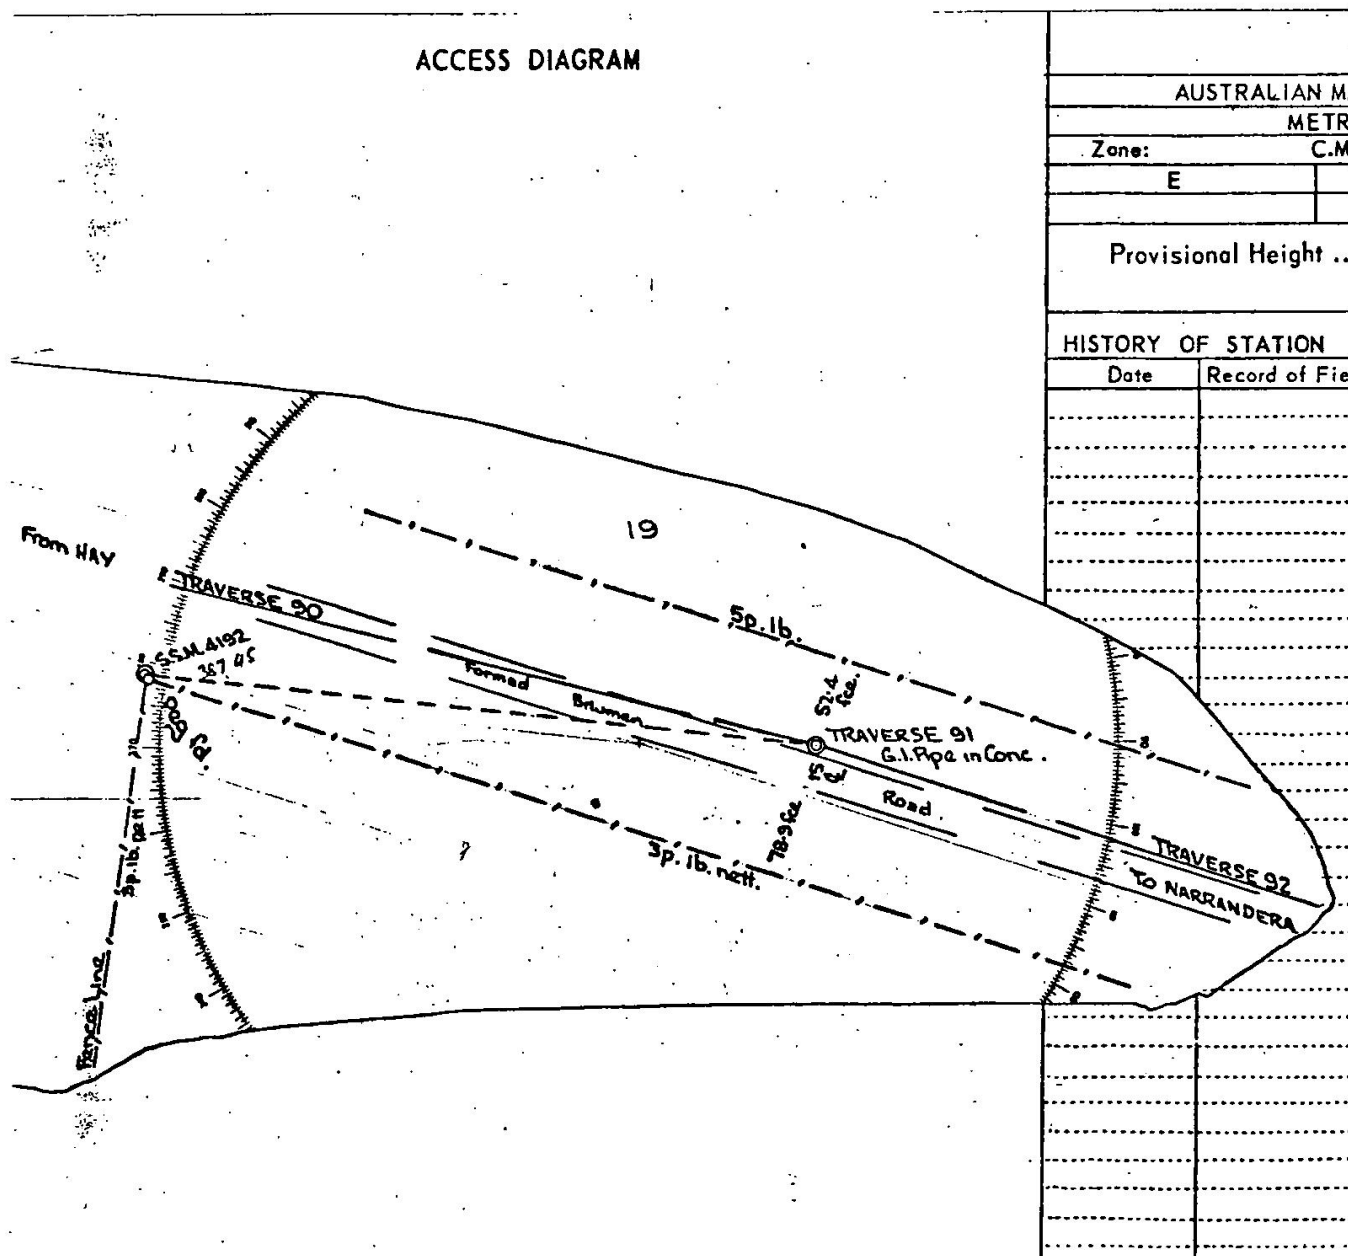

AUSTRALIAN M.

METR

Zone: C.M

E

Provisional Height ..

## HISTORY OF STATION

Date Record of File