

GEODETTIC SURVEY OF N.S.W.

CENTRAL MAPPING AUTHORITY

GEODETTIC STATION RECONNAISSANCE and MAINTENANCE REPORT

- Description:
1. Cleared by lanes bearing..... Note: Cross out word or words which do not apply
..... from Trig. Mast
 2. Mast & Vanes have been painted white & black respectively.
 3. The station/pillar was unpiled/not unpiled/constructed on..... 19..... dimensions now being:
Description of mark..... should be explicit, e.g., S/Steel Pillar Plate, Steel plug-Bronze plug, Bolt, G.I. Pipe
Height of mark.....m. ^{above} rock/concrete; Mark is.....m. ^{above} G.L.
 4. A.....m. Diameter of Top Vanes to Top Mark/Pillar plate.....m. Diameter of Vanes (vertical).....m.
Height of Cairn.....m. Diameter of Cairn.....m. Name Plate found/not found/placed.
Length of Mast.....m. (approximate if not unpiled)
 5. A..... set in conc./rock has been placed/found, bearing.....° M from Mast/Plug/Pillar
 6. A..... set in conc./rock has been placed/found, bearing.....° M from Mast/Plug/Pillar
 7. A..... set in conc./rock has been placed/found, bearing.....° M from Mast/Plug/Pillar
 8. Action required:.....

STANDPOINT:

Mark	Direction	Horiz. Distance	Height Difference	Mark	Direction	Horiz. Distance	Height Difference
			above standpt.				above standpt.
			below				below
			above standpt.				above standpt.
			below				below
Prepared by: *G. Hanna* 8/5/79 Checked: _____

S: 2733-1

Noted on U.T.M. Card


STATION: **GOUROCK** No.: **2284**

MAP SHEET SCALE 1:250 000 **CANBERRA**

INSPECTED BY: **G. C. HANNA** DATE: **27/5/79**

AUTHORITY: **C. M. A.** FIELD BOOK:


B: 2788-2 D. West, Government Printer

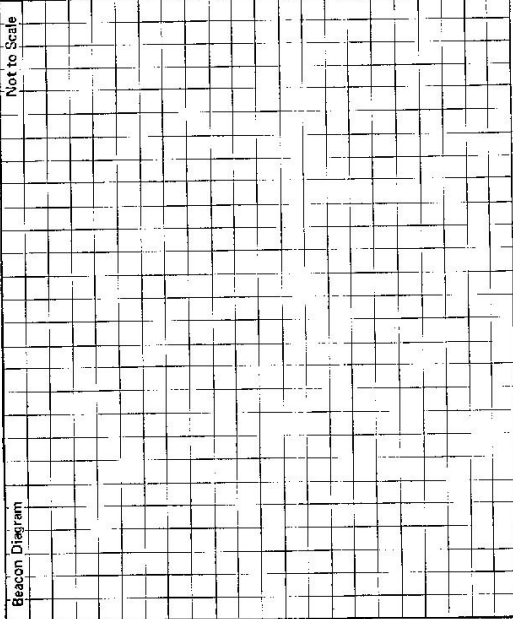

STATION **GOUROCK** TS **2284**

Owner's Name:
 Address:
 Phone:
 Current Occupant:
 Address:
 Phone:

ACCESS
 Access Report of **25/19/19** was found suitable/unsuitable.

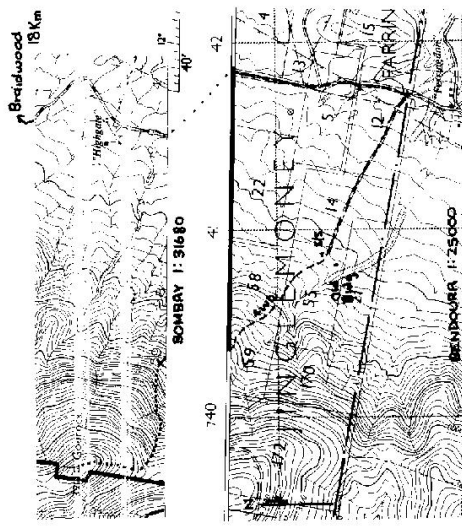

For further information see:
 Bombay 8827-III-S
 Bendoura 8826-N-N

This section to be completed by officer constructing pillar.

Original station mark found/not found.
 Description of mark:
 Original beacon found/not found.
 Description of beacon:
 Height Top of Vanes to Top Mark:m.
 Height of mark:m. above G.L. below G.L.
 Diameter of Vanes:m. Height of Cairnm.
 Original Beacon has/has not been destroyed by me.

Date	Record of Station