

GEODETTIC SURVEY OF M.S.W.

CENTRAL MAPPING AUTHORITY

GEODETTIC STATION RECONNAISSANCE and MAINTENANCE REPORT

Description: *Not cleared* **35-215** *Clearing* **Notes: Cross out word or words which do not apply**  
 1. Cleared by *hence bearing* **215-35** *in 2 days clearing* **DATE: 9-10-78**

2. **Mast & Vanes have been painted white & black respectively, mast & vanes in fair condition**

3. The station/pillar was ~~supplied~~/not supplied/~~constructed on~~ **19** *.....*, dimensions now being:

Description of mark *.....* should be explicit, e.g., S/Steel Pillar Plate, Steel plug, Brass plug, Bolt, G.I. Pipe

Height of mark *.....* m. <sup>above</sup>/<sub>below</sub> rock/concrete; Mark is *.....* m. <sup>above</sup>/<sub>below</sub> G.L.

Height of Top Vanes to Top Mark/Pillar plate *.....* m. Diameter of Vanes (vertical) **0.95** m.

Height of Cairn **1.25** m. Diameter of Cairn **1.9** m. Name Plate ~~found~~/not found/~~found~~.

Length of Mast **4.5** m. (approximate if not unplied)

4. A **5.5 M** *.....* set in conc/~~rock~~ has been ~~placed~~/found, bearing **218** °M from Mast/~~plug~~/pillar

5. A *.....* set in conc/rock has been placed/found, bearing *.....* °M from Mast/Plug/Pillar

6. A *.....* set in conc/rock has been placed/found, bearing *.....* °M from Mast/Plug/Pillar

7. A *.....* set in conc/rock has been placed/found, bearing *.....* °M from Mast/Plug/Pillar

8. Action required: **TOW RANGING**  
**1:25,000**

STANDPOINT:

Mark	Direction	Horiz. Distance	Height Difference	Mark	Direction	Horiz. Distance	Height Difference
			above standpt.				above standpt.
			below				below
			above standpt.				above standpt.
			below				below
Prepared by: *[Signature]* Checked: *[Signature]* Noted on U.T.M. Card

SI 2738-1

STATION: **GOVERNOR** No.: **72285**

MAP SHEET **Goulburn**

SCALE 1:250 000

INSPECTED BY: **G. Dickson** DATE: **8-6-78**

**A. Sivertsen**

AUTHORITY: **CMA** FIELD BOOK: **1642**

Station Diagram

Checked

81 2733-2 D. West, Government Printer

STATION		GOVERNOR IS 2285
<p>Owner's Name: .....</p> <p>Address: .....</p> <p>Phone: .....</p> <p style="text-align: center;"><u>ACCESS</u></p> <p>8 6 78 Access Report of 8/10/1978 was found suitable/unsuitable.</p> <p>0.0 Goulburn P.O. take Hwy. north</p> <p>3.7 Turn left at cemetery GOODMAN ROAD</p> <p>4.5 Pass track on R</p> <p>4.6 Turn R onto wheel tracks &amp; follow ever contour banks</p> <p>5.1 Governor Δ</p>	<p>Current Occupant: .....</p> <p>Address: .....</p> <p>Phone: .....</p>	<p>Not to Scale</p> <div style="border: 1px solid black; width: 100%; height: 100%; background-image: linear-gradient(to right, 1px solid black, 1px solid transparent), linear-gradient(to bottom, 1px solid black, 1px solid transparent); background-size: 20px 20px;"> </div> <p>This section to be completed by officer constructing pillar.</p> <p>Original station mark found/not found.</p> <p>Description of mark: .....</p> <p>Original beacon found/not found.</p> <p>Description of beacon: .....</p> <p>Height Top of Vanes to Top Mark.....m.</p> <p>Height of mark.....m. above rock/conc.....m. below G.L.</p> <p>Diameter of Vanes .....m. Height of Cairn .....m.</p> <p>Original Beacon has/has not been destroyed by ma.</p>
		<p>Date</p> <p>Record of Station</p>

CENTRAL MAPPING AUTHORITY

GEODETIC SURVEY OF N.S.W.


GEODETIC STATION RECONNAISSANCE and MAINTENANCE REPORT

STATION: **GOVERNOR** No.: 2285

MAP SHEET: **GOVERNOR**  
SCALE: 1:250 000

INSPECTED BY: **M. CLARK** DATE: **6-4-81**

AUTHORITY: **C.M.H.** FIELD BOOK:

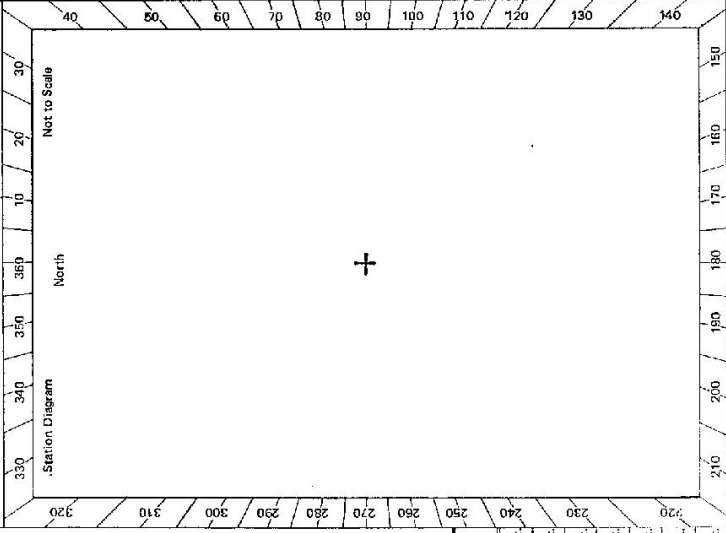

- Description:
- Note: Cross out word or words which do not apply
- Cleared by lanes bearing..... from Trig. Mast
  - Mast & Vanes have been painted white & black respectively.
  - The station/pillar was unpiled/not unpiled/constructed on..... 19....., dimensions now being: Description of mark.....should be explicit, e.g., S/Steel Pillar Plate, Steel plug, Brass plug, Bolt, G.I. Pipe
  - Height of mark.....m. <sup>above</sup> rock/concrete; Mark is.....m. <sup>above</sup> G.L.
  - Height of Top Vanes to Top Mark/Pillar plate.....m. Diameter of Vanes (vertical).....m.
  - Height of Cairn.....m. Diameter of Cairn.....m. Name Plate found/not found/placed.
  - Length of Mast.....m. (approximate if not unpiled)
  - A.....set in conc./rock has been placed/found, bearing.....° M from Mast/Plug/Pillar
  - A.....set in conc./rock has been placed/found, bearing.....° M from Mast/Plug/Pillar
  - A.....set in conc./rock has been placed/found, bearing.....° M from Mast/Plug/Pillar
  - A.....set in conc./rock has been placed/found, bearing.....° M from Mast/Plug/Pillar
  - Action required:.....

STANDPOINT:

Mark	Direction	Horiz. Distance	Height Difference	Mark	Direction	Horiz. Distance	Height Difference
			above standpt.				above standpt.
			below				below
			above standpt.				above standpt.
			below				below
Prepared by: **Michael Clark** 13-5-81 Checked: **g**

Noted on U.T.M. Card **g** 15-3-85 Checked

GS 24

<p>STATION <b>Governor TS 2285</b></p> <p>Owner's Name: .....                  Address: .....                  Phone: .....</p> <p>Current Occupant: .....                  Address: .....                  Phone: .....</p> <p style="text-align: center;"><u>ACCESS</u></p> <p>Access Report of <u>6.1.19</u> was found suitable/unavailable.</p> <p>Most Vanes and rock cairn found in good condition.                  Most and vanes in need of painting                  One to two weeks clearing required for 360° sighting</p>	<table border="1" style="width: 100%; border-collapse: collapse;"> <tr> <td style="width: 50%; text-align: center;">Not to Scale</td> <td></td> </tr> <tr> <td colspan="2" style="text-align: center;">                     This section to be completed by officer constructing pillar.                      Original station mark found/not found.                 </td> </tr> <tr> <td colspan="2">                     Description of mark: .....                      Original beacon found/not found.                 </td> </tr> <tr> <td colspan="2">                     Description of beacon: .....                      Height Top of Vanes to Top Mark .....m.                      Height of mark .....m above below G.L.                      Diameter of Vanes .....m Height of Cairn .....m.                      Original Beacon has/has not been destroyed by me.                 </td> </tr> </table>	Not to Scale		This section to be completed by officer constructing pillar. Original station mark found/not found.		Description of mark: ..... Original beacon found/not found.		Description of beacon: ..... Height Top of Vanes to Top Mark .....m. Height of mark .....m above below G.L. Diameter of Vanes .....m Height of Cairn .....m. Original Beacon has/has not been destroyed by me.			
Not to Scale											
This section to be completed by officer constructing pillar. Original station mark found/not found.											
Description of mark: ..... Original beacon found/not found.											
Description of beacon: ..... Height Top of Vanes to Top Mark .....m. Height of mark .....m above below G.L. Diameter of Vanes .....m Height of Cairn .....m. Original Beacon has/has not been destroyed by me.											
<table border="1" style="width: 100%; border-collapse: collapse;"> <tr> <td style="width: 50%; text-align: center;">Data</td> <td style="width: 50%; text-align: center;">Record of Station</td> </tr> <tr> <td> </td> <td> </td> </tr> <tr> <td> </td> <td> </td> </tr> <tr> <td> </td> <td> </td> </tr> <tr> <td> </td> <td> </td> </tr> </table>		Data	Record of Station								
Data	Record of Station										