

CENTRAL MAPPING AUTHORITY

GEODETIC SURVEY OF M.S.W.

GEODETIC STATION RECONNAISSANCE and MAINTENANCE REPORT

- Description: *Note: Cross out word or words which do not apply*
1. Cleared by lanes bearing..... from Trig. Mast
  2. Mast & Vanes have been painted white & black respectively.
  3. The station/pillar was unpiled/not unpiled/constructed on..... 19....., dimensions now being:  
Description of mark.....should be explicit, e.g., S/Steel Pillar Plate, Steel plug, Brass plug, Bolt, G.I. Pipe  
Height of mark.....m. above below rock/concrete; Mark is.....m. above below G.L.  
Height of Top Vanes to Top Mark/Pillar plate.....m. Diameter of Vanes (vertical).....m.  
Height of Cairn.....m. Diameter of Cairn.....m. Name Plate found/not found/placed.  
Length of Mast.....m. (approximate if not unpiled)
  4. A.....set in conc/rock has been placed/found, bearing.....°M from Mast/Plug/Pillar
  5. A.....set in conc/rock has been placed/found, bearing.....°M from Mast/Plug/Pillar
  6. A.....set in conc/rock has been placed/found, bearing.....°M from Mast/Plug/Pillar
  7. A.....set in conc/rock has been placed/found, bearing.....°M from Mast/Plug/Pillar
  8. Action required:.....

STANDPOINT:

Mark	Direction	Horiz. Distance	Height Difference	Mark	Direction	Horiz. Distance	Height Difference
			above standpt.				above standpt.
			below standpt.				below standpt.
			above standpt.				above standpt.
			below standpt.				below standpt.
Prepared by: *[Signature]* 20/11/18 Checked: *[Signature]*

Noted on U.T.M. Card

Sr 2733-1

STATION: GREEN G.S. (WATER GREENING) No: 2311

MAP SHEET SCALE 1:250 000

INSPECTED BY: M.L. MORRISON DATE: 20/11/18

AUTHORITY: CMAA FIELD BOOK: 1711

Station Diagram

North

Not to Scale


Top set in four conditions needs new mast and vanes no other marks for No Clearing required - total 4.11 Trig. h. 1.1 is lower than surrounding ranges.

+

Checked

St 2733-2 D. West, Government Printer

Beacon Diagram

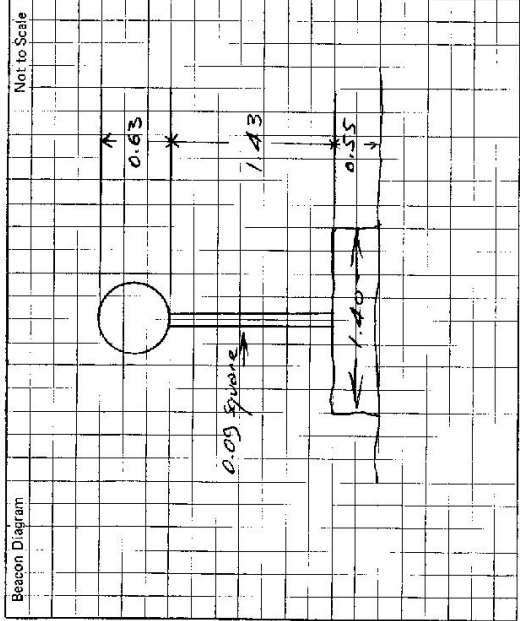

This section to be completed by officer constructing pillar.

Original station mark found/not found.

Description of mark: .....

Original beacon found/not found.

Description of beacon: .....

Height Top of Vanes to Top Mark.....m.

Height of mark.....m. above G.L.  
below

Diameter of Vanes .....m. Height of Cairn .....m.

Original Beacon has/has not been destroyed by me.

STATION GREEN G.S. IS 2311

Owner's Name: .....  
 Address: .....  
 Phone: .....  
 Current Occupant: .....  
 Address: .....  
 Phone: .....

ACCESS

Access Report of 21/11/1978, was found suitable/unavailable.

0.00 TRAVEL TO. HEAD TOWARDS BULLBURN  
 0.10 TURN LEFT FOLLOW RD TO BARRABY 16  
 5.20 TURN LEFT INTO BIRT RD AT MILLER'S CORNER  
 5.70 GATE & GATE AT SATTLE YARDS  
 5.95 TAKE RH FURK  
 8.55 PASS BRIDGE ON LEFT TURN LEFT TOWARDS GATE  
 8.60 THROUGH GATE FOLLOW TRACK DOWN TO CREEK CROSSING  
 9.10 GATE JUST AFTER CREEK CROSSING FOLLOW TRACK  
 9.50 GATE  
 9.70 TURN LEFT ONCE TRACK FOLLOW ROUND BEHIND DAM  
 9.85 CROSS OLD FENCE LINE HEAD UP ROCKY HILL  
 10.10 TRIG.

Date

Record of Station