


STATION 311 GREEN HILLS TS 2314

Owners Name.....
 Current Occupant.....

Address.....
 Address.....

Access 2-4-1976
 Trig is beside Range control office in Holsworthy Firing range. Follow Moorebank Ave through into army land and TS is on right after about 1km.

Station Diagram Not to Scale

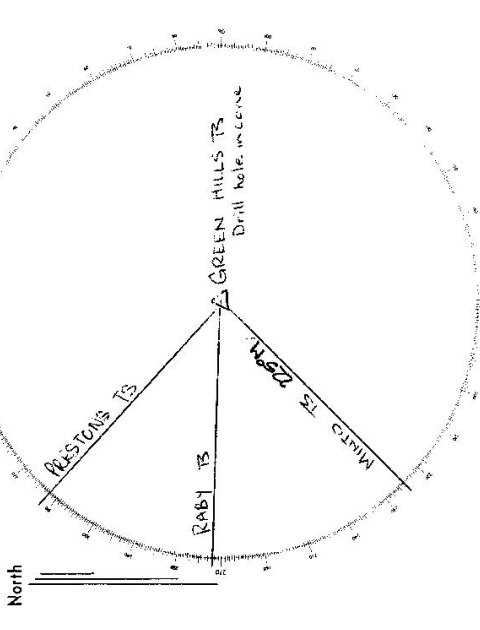

List of Observed Directions:-

Standpoint: Drill hole in concrete		Standpoint:	
Station	Direction	Station	Direction
RUSTONS TS	61° 00' 00"		
MUNTO TS	273° 21' 12"		
RABY TS	326° 53' 14.7"		
Station	Direction	Station	Direction