

GEODEIC SURVEY OF N.S.W.

CENTRAL MAPPING AUTHORITY

GEODEIC STATION RECONNAISSANCE and MAINTENANCE REPORT


STATION: GREENWICH No.: 2322

MAP SHEET SCALE 1:250 000
 Goulburn

INSPECTED BY: A. Sversten
 DATE: 2-11-78

AUTHORITY: CMA
 FIELD BOOK: 1709

- Description: *Note: Cross out word or words which do not apply*
- Cleared by lanes bearing... ~~Timbered... 300' - medium/light timber.~~ from Trig. Mast
 by 2-3 days clearing
 - Mast & Vanes have been painted white & black respectively.
 - The station/pillar was unpiled/not unpiled/constructed on..... 19....., dimensions now being:
 Description of mark..... should be explicit, e.g., S/Steel Pillar Plate, Steel plug, Brass plug, Bolt, G.I. Pipe
 Height of mark..... m. ^{above} rock/concrete; Mark is..... m. ^{above} G.L.
 Height of Top Vanes to Top Mark/Pillar plate..... m. Diameter of Vanes (vertical)..... m.
 Height of Cairn..... m. Diameter of Cairn..... m. Name Plate found/not found/placed.
 Length of Mast..... m. (approximate if not unpiled)
 - A..... set in conc/rock has been placed/found, bearing.....° M from Mast/Plug/Pillar
 - A..... set in conc/rock has been placed/found, bearing.....° M from Mast/Plug/Pillar
 - A..... set in conc/rock has been placed/found, bearing.....° M from Mast/Plug/Pillar
 - A..... set in conc/rock has been placed/found, bearing.....° M from Mast/Plug/Pillar
 - Action required:..... CHATSBURY 1:25,000

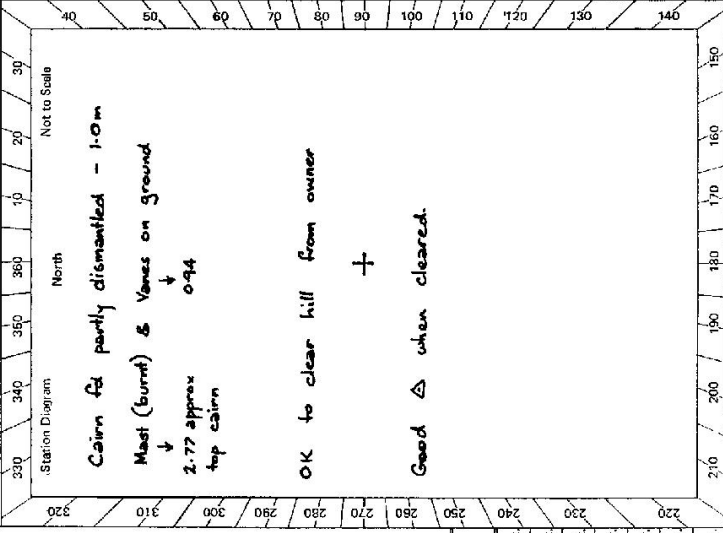

STANDPOINT:			
Mark	Direction	Horiz. Distance	Height Difference
			above standpt.
			below standpt.
			above standpt.
			below standpt.
Prepared by: [Signature]

Checked: [Signature]

Noted on U.T.M. Card

CENTRAL MAPPING AUTHORITY

GEODETIC SURVEY OF N.S.W.

GEODETIC STATION RECONNAISSANCE and MAINTENANCE REPORT

- Description:
- Cleared by lanes bearing..... *110° 30' 00"* from Trig. Mast
Note: Cross out word or words which do not apply
 - Mast & Vanes have been painted white & black respectively, X
 - The station/~~marker~~ was ~~unplaced~~/~~not unplaced~~/~~constructed~~ on..... *19.24. May* 19*24*....., dimensions now being:
 Description of mark..... should be explicit, e.g., S/Steel Pillar Plate, Steel plug, Brass plug, Bolt, G.I. Pipe
 Height of mark.....m. above rock/concrete; Mark is.....m. above G.L.,
 Height of Top Vanes to Top Mark/Pillar plate.....m. Diameter of Vanes (vertical).....*1*.....m.
 Height of Cairn.....m. Diameter of Cairn.....*1.4*.....m. Name Plate ~~found~~/~~not found~~/~~placed~~.
 Length of Mast.....m. (approximate if not unplaced)
 - A..... set in conc/rock has been placed/~~found~~, bearing.....°M from Mast/Plug/Pillar
 - A..... set in conc/rock has been placed/~~found~~, bearing.....°M from Mast/Plug/Pillar
 - A..... set in conc/rock has been placed/~~found~~, bearing.....°M from Mast/Plug/Pillar
 - A..... set in conc/rock has been placed/~~found~~, bearing.....°M from Mast/Plug/Pillar
 - Action required:.....

STANDPOINT:

Mark	Direction	Horiz. Distance	Height Difference	Mark	Direction	Horiz. Distance	Height Difference
			above standpt below				above standpt below
			above standpt below				above standpt below
STANDPOINT:

Mark	Direction	Horiz. Distance	Height Difference	Mark	Direction	Horiz. Distance	Height Difference
			above standpt below				above standpt below
			above standpt below				above standpt below
Prepared by: *D.J. KAND*

Checked: *Noted on U.T.M. Card*

STATION: *Green Hill (Geodetic Station)* No.: *2322*
 MAP SHEETS SCALE: *1:250 000* *Green Hill* SCALE: *1:100 000* *Green Hill*
 INSPECTED BY: *D.J. KAND* DATE: *11 May 1984*
 AUTHORITY: *C.M.A.* FIELD BOOK: *1954*

Station Diagram

Station Diagram

North

Not to Scale

330 320 310 300 290 280 270 260 250 240 230 220

30 20 10 0 10 20 30

40 50 60 70 80 90 100 110 120 130 140

210 200 190 180 170 160 150 140

Station Would Contain Good View in all directions if cleared 3m

Green Hill

Remains of Mast & Vanes Found 1.7m on the Ground

Checked ND

RS-2735-2 D. West, Government Printer

Beacon Diagram 	Not to Scale	<p style="text-align: right;">STATION <u>Greenwich Gravel Station TS 2322</u></p> <p> Owner Name: <u>Greenwich Gravel Company</u> Current Occupant: Address: Phone: <u>(048) 515151</u> ACCESS: <u>11-5-1984</u> </p> <p> Access Report of <u>7.11.1984</u> was found <u>accessible/unsuitable</u> <u>K.M.</u> <u>0.00</u> At <u>POULDEN RD. TAKE HIGHWAY NORTH</u> <u>10.70</u> Then <u>LEFT</u> onto <u>GREENWICH PARK, TOWNERS ROAD</u> <u>26.50</u> Pass <u>ROAD</u> on <u>RIGHT</u> <u>32.00</u> Turn <u>RIGHT</u> into <u>GREENWICH PARK</u> <u>32.05</u> Call in at <u>house</u> on <u>RIGHT</u> then <u>GO</u> <u>LEFT</u> down <u>drive</u> toward <u>GRAB</u> <u>32-10</u> <u>GRAB</u>, take <u>LEFT</u> fork and <u>KEEP</u> to <u>RIGHT</u> of <u>BUILDING</u> <u>32-40</u> Through <u>LEFT</u> gate and to <u>down</u> <u>LANE</u> <u>32.80</u> <u>GATE</u> <u>32.90</u> <u>LAUSEMAY</u> <u>33.00</u> <u>GO</u> to <u>RIGHT</u> of <u>DAW</u> <u>33.30</u> <u>GATE</u> at <u>YARD</u> <u>33.70</u> <u>CROSS</u> <u>DRIVE</u> above <u>DAW</u> <u>33.80</u> <u>GATE</u> - then <u>GO</u> to <u>RIGHT</u> of <u>HILLOCK</u> and <u>ACCESS</u> <u>SADDLE</u> <u>34.50</u> <u>KEEPING</u> to <u>6</u> ft. S. of <u>MAIN</u> <u>HILL</u> <u>34.75</u> <u>GATE</u> - then <u>TURN</u> <u>UP</u> <u>FENCE</u> to <u>RIGHT</u> <u>35.25</u> At <u>TOP</u> and <u>CENTRE</u> of <u>SADDLE</u> turn into <u>timber</u> <u>hollow</u> winding <u>UP</u> <u>TRAIL</u> through <u>timber</u> <u>END</u> of <u>TRAIL</u>. <u>WALK</u> is <u>ABOUT</u> <u>10</u> <u>MINUTES</u> along <u>SADDLE</u> To <u>CLEAR</u> <u>VEH</u> <u>CLEAR</u> <u>TRAIL</u> in <u>SADDLE</u> then <u>UP</u> to <u>STATION</u> <u>LAST</u> <u>WALKING</u> <u>TRAIL</u> <u>WOULD</u> <u>PASS</u> <u>THROUGH</u> <u>SADDLE</u> <u>TRAIL</u> then <u>UP</u> <u>GENTLE</u> <u>SLOPE</u> to <u>STATION</u>. </p>
This section to be completed by officer constructing pillar. Original station mark found/not found. Description of mark: Original beacon found/not found. Description of beacon: Height Top of Vane to Top Mark m. Height of mark m. above / below G.L. Diameter of Vane m. Height of Cairn m. Original Beacon has/has not been destroyed by me.		Record of Station Date