

GEODETIC SURVEY OF N.S.W.

CENTRAL MAPPING AUTHORITY

GEODETIC STATION RECONNAISSANCE and MAINTENANCE REPORT

STATION: **GRAFFITHS** No.: **2332**


MAP SHEET **BATHURST**  
SCALE 1:250 000

INSPECTED BY: **A. GARSIDE** DATE: **19-8-81**

AUTHORITY: **C.M.A.** FIELD BOOK: **1986**

Description:

1. Cleared by lanes bearing.....**150°** - **330°**  
*Note: Cross out word or words which do not apply*
2. Mast & Vanes have been painted white & black respectively.
3. The station/~~pillar~~ was ~~erected~~/not unplaced/~~erected~~ on.....**19.9**.....**19.9**..... dimensions now being:  
Description of mark.....should be explicit, e.g., S/Steel Pillar Plate, Steel plug, Brass plug, Bolt, G.I. Pipe  
Height of mark.....<sup>above</sup>.....<sup>below</sup>.....m. rock/concrete; Mark is.....<sup>above</sup>.....<sup>below</sup>.....m. G.L.  
Height of Top Vanes to Top Mark/Pillar plate.....m. Diameter of Vanes (vertical).....**0.76**.....m.  
Height of Cairn.....**1.5**.....m. Diameter of Cairn.....**1.5**.....m. Name Plate found/not found/placed.  
Length of Mast.....**3**.....m. (approximate if not unplaced)
4. A.....set in conc/rock has been placed/found, bearing.....**330°**.....**3**M from Mast/Plug/Pillar
5. A.....set in conc/rock has been placed/found, bearing.....**330°**.....**3**M from Mast/Plug/Pillar
6. A.....set in conc/rock has been placed/found, bearing.....**330°**.....**3**M from Mast/Plug/Pillar
7. A.....set in conc/rock has been placed/found, bearing.....**330°**.....**3**M from Mast/Plug/Pillar
8. Action required:.....**STATION IS OF LITTLE VALUE FOR MAPPING**.....

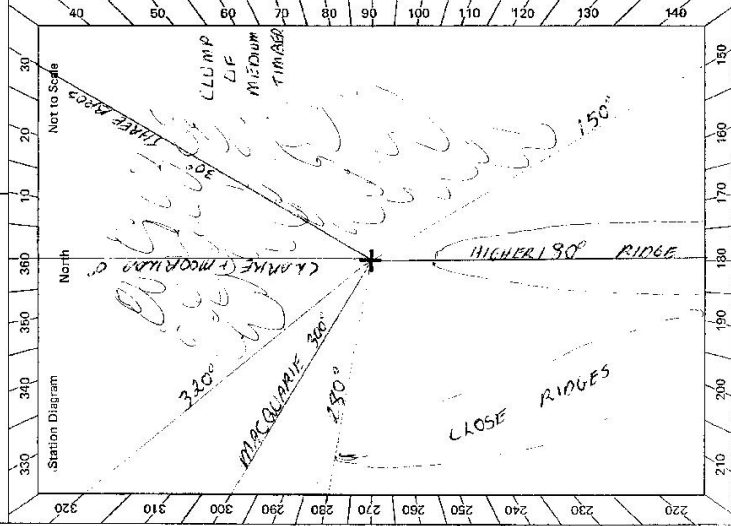

STANDPOINT:							
Mark	Direction	Horiz. Distance	Height Difference	Mark	Direction	Horiz. Distance	Height Difference
			above standpt.				above standpt.
			below				below
			above standpt.				above standpt.
			below				below
Prepared by: *[Signature]* 15/10/81 Checked: *[Signature]* Noted on U.T.M. Card

