

GEODETTIC SURVEY OF N.S.W.

CENTRAL MAPPING AUTHORITY


GEODETTIC STATION RECONNAISSANCE and MAINTENANCE REPORT

STATION: **GRONG GRONG** No.: **2333**

MAP SHEET SCALE 1:250 000 **NARRANDERA**

INSPECTED BY: **G. KEEP / J. WALLACE** DATE: **23.7.82**

AUTHORITY: **C. M. A.** FIELD BOOK:

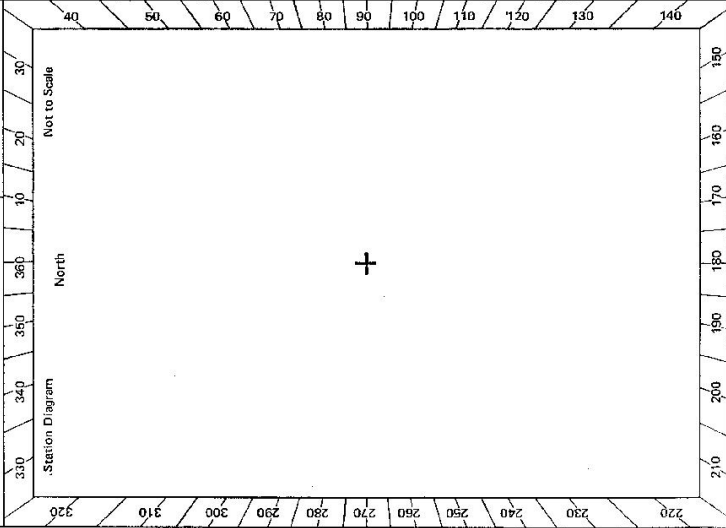

- Description:
1. Cleared by Janes bearing. *Note: Cross out word or words which do not apply*
2. ~~Mast & Vanes have been painted white & black respectively.~~
3. The station/pillar was unpiled/not unpiled/constructed on.....19....., dimensions now being:
- Description of mark.....~~Brass Plug~~.....should be explicit, e.g., S/Steel Pillar Plate, Steel plug, Brass plug, Bolt, G.I. Pipe
- Height of mark.....m. ^{above} rock/concrete; Mark is.....m. ^{above} G.L. _{below}
- Height of Top Vanes to Top Mark/Pillar plate.....m. Diameter of Vanes (vertical).....m.
- Height of Cairn.....m. Diameter of Cairn.....m. Name Plate found/not found/placed.
- Length of Mast.....m. (approximate if not unpiled)
4. A.....~~SSM 20.12~~.....set in conc/~~rock~~ has been placed/found, bearing.....~~7~~.....° M from Mast/Plug/Pillar @ 4.72 m
5. A.....set in conc/rock has been placed/found, bearing.....° M from Mast/Plug/Pillar
6. A.....set in conc/rock has been placed/found, bearing.....° M from Mast/Plug/Pillar
7. A.....set in conc/rock has been placed/found, bearing.....° M from Mast/Plug/Pillar
8. Action required: **36.0° clearing**

STANDPOINT:

Mark	Direction	Horiz. Distance	Height Difference	Mark	Direction	Horiz. Distance	Height Difference
			above standpt.				above standpt.
			below				below
			above standpt.				above standpt.
			below				below
Prepared by: *Goffy Keep* + 8.82 Checked: *Checked*

Noted on U.T.M. Card

SY 2733-1

STATION **GRONG GRONG TS 2333**


Owner's Name:
 Address:
 Phone:

Current Occupant:
 Address:
 Phone:

Access Report of 12/7/1982 was found suitable/unsuitable.

ACCESS

For access see Bagalong Hills 1:50 000

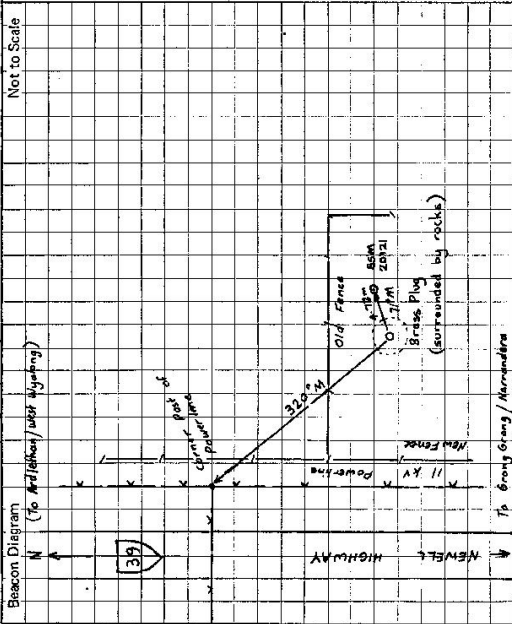

This section to be completed by officer constructing pillar.

Original station mark found/not found.

Description of mark:

Original beacon found/not found.

Description of beacon:

Height Top of Vanes to Top Markm.

Height of markm. above G.L.
m. below

Diameter of Vanesm. Height of Cairnm.

Original Beacon has/has not been destroyed by me.

Date	Record of Station