

GEODETTIC SURVEY OF NSW

GEODETTIC STATION RECONNAISSANCE and MAINTENANCE REPORT

CENTRAL MAPPING AUTHORITY

STATION: **CACUE ROCKS** No.: **2339**

MAP SHEET SCALE 1:250 000 **BATHURST**

INSPECTED BY: **A. GARSIDE** DATE: **14-8-81**

AUTHORITY: **CMA** FIELD BOOK: **199C**

Description: **15° 35' 16.0" 74.0°**
 Note: *Cross out word or words which do not apply*

1. Cleared by lanes bearing..... **15° 35' 16.0" 74.0°**..... from Trig, Mast

2. Mast & Vanes have been painted white & black respectively.

3. The station/pillar was unplaced/not unplaced/constructed on..... **1.4 - 8 - 81**..... **19%**..... dimensions now being:

Description of mark..... should be explicit, e.g., S/Steel Pillar Plate, Steel plug, Brass plug, Bolt, G.I. Pipe

Height of mark..... m. ^{above} _{below} rock/concrete; Mark is..... m. ^{above} _{below} G.I.L.

Height of Top Vanes to Top Mark/Pillar plate..... m. Diameter of Vanes (vertical)..... m. **NO VANES**

Height of Cairn..... m. Diameter of Cairn..... **1.5**..... m. Name Plate found/not found/placed.

Length of Mast..... **3**..... m. (approximate if not unplaced)

4. A..... set in conc/rock has been placed/found, bearing..... °M from Mast/Plug/Pillar

5. A..... set in conc/rock has been placed/found, bearing..... °M from Mast/Plug/Pillar

6. A..... set in conc/rock has been placed/found, bearing..... °M from Mast/Plug/Pillar

7. A..... set in conc/rock has been placed/found, bearing..... °M from Mast/Plug/Pillar

8. Action required: **STATION IS OF LITTLE VALUE COULD BE USED FOR MAPPING**

STANDPOINT:


Mark	Direction	Horiz. Distance	Height Difference	Mark	Direction	Horiz. Distance	Height Difference
			above standpt.				above standpt.
			below standpt.				below standpt.
			above standpt.				above standpt.
			below standpt.				below standpt.
			above standpt.				above standpt.
			below standpt.				below standpt.
			above standpt.				above standpt.
			below standpt.				below standpt.

Prepared by: *[Signature]* 15/10/81

Checked: *[Signature]*

SI 2739-1

Noted on U.T.M. Card

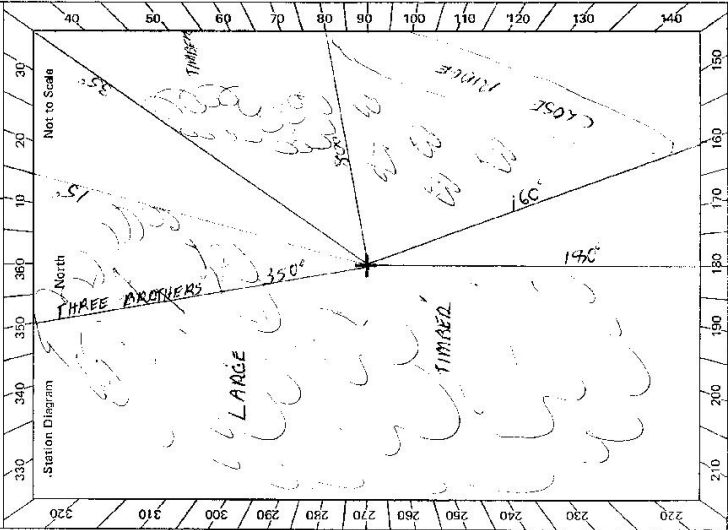

St 2753--2 D. West, Government Printer

STATION	GROVE ROCKS TS 2339
Owner's Name: <u>NOT CONTACTED</u>	Current Occupant:
Address:	Address:
Phone:	Phone:
<u>ACCESS</u>	
Access Report of <u>M.D. 1981</u> was found suitable/unsuitable: ---	
KM 0 0 2.5 2.8 3 0	FEATURE ON AATHURST GOLFCLUB ROAD INTERSECTION AATHURST 38 HOBBS YDS 10 TURNKEY RD. TRAVEL TOWARDS TURNKEY TURN RIGHT THROUGH WOODEN GATE AND FOLLOW TRACK AROUND BEHIND HUT TURN LEFT OFF TRACKS FOLLOW EDGE OF TIMBER LINE UP TO FENCE AND TRAIL GROVE ROCKS C.S.

Beacon Diagram	Not to Scale	
This section to be completed by officer constructing pillar. Original station mark found/not found. Description of mark: Original beacon found/not found. Description of beacon: Height Top of Vane to Top Mark.....m. Height of mark.....m. above rock/cone.....m. below G.L. Diameter of Vane.....m. Height of Cairn.....m. Original Beacon has/has not been destroyed by me.		

Date	Record of Station