

CENTRAL MAPPING AUTHORITY

GEODETIC SURVEY OF N.S.W.

GEODETIC STATION RECONNAISSANCE and MAINTENANCE REPORT

STATION: **GUAGONG** No.: **2342**


Description:

1. Cleared by lanes bearing..... *Note: Cross out word or words which do not apply*..... from Trig. Mast
2. Mast & Vanes have been painted white & black respectively.
3. The station/pillar was unpiled/not unpiled/constructed on..... 19....., dimensions now being:
Description of mark.....should be explicit, e.g., S/Steel Pillar Plate-Steel plug-Brass plug, Bolt, G.I. Pipe
Height of mark.....m, above below
Mark is.....m, above below G.L.
- Height of Top Vanes to Top Mark/Pillar platem. Diameter of Vanes (vertical).....m.
- Height of Cairn.....m. Diameter of Cairn.....m. Name Plate found/not found/placed.
- Length of Mast.....m. (approximate if not unpiled)
4. A.....set in conc/rock has been placed/found, bearing.....° M from Mast/Plug/Pillar
5. A.....set in conc/rock has been placed/found, bearing.....° M from Mast/Plug/Pillar
6. A.....set in conc/rock has been placed/found, bearing.....° M from Mast/Plug/Pillar
7. A.....set in conc/rock has been placed/found, bearing.....° M from Mast/Plug/Pillar
8. Action required:.....

MAP SHEET SCALE 1:250 000 **CARGELLIGO**

INSPECTED BY: **G.C. HANNA** DATE: **28/5/19**

AUTHORITY: **C.M.A.** FIELD BOOK:

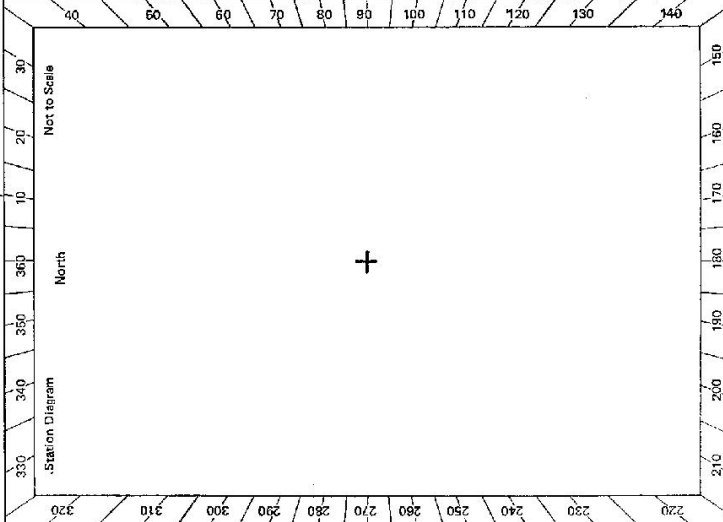

STANDPOINT:


Mark	Direction	Horiz. Distance	Height Difference	Mark	Direction	Horiz. Distance	Height Difference
			above standpt.				above standpt.
			below				below
			above standpt.				above standpt.
			below				below
Prepared by: *G. Hanna* 28/5/19 Checked: *[Signature]*

Noted on U.T.M. Card

Sr: 2759-2 D. West, Government Printer

STATION **GUARDING TS 2342**

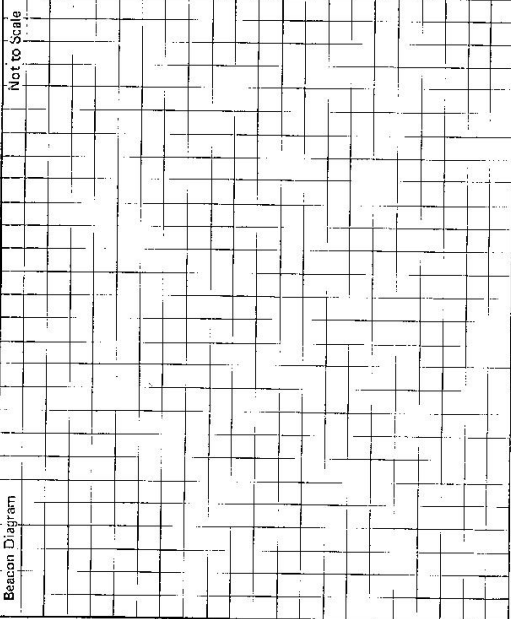

Owner's Name:
 Address:
 Phone:
 Current Occupant:
 Address:
 Phone:

ACCESS

Access Report of **25/5/19** was found suitable/unsuitable.

Cairn found. M&V destroyed.

Drive to.

Heavy cleaning required

See Kiacatoo 8231 - N

This section to be completed by officer constructing pillar.

Original station mark found/not found.

Description of mark:

Original beacon found/not found.

Description of beacon:

Height Top of Vanes to Top Markm.

Height of markm. above rock/conc. below G.L.

Diameter of Vanesm. Height of Cairnm.

Original Beacon has/has not been destroyed by me.

Date	Record of Station