

TS. 2358

Central Mapping Authority

Trigonometrical Survey of F.S.W.

RECONNAISSANCE and MAINTENANCE REPORT on GUNDAM TRIG. STATION

Parish SOUTH COLAH County CUMBERLAND Map Sheet BEROWRA 1:4000 I.S.G. No. 0976

Inspected by R.G. HANNA Date of Inspection 20TH JULY 1972

This Trig. Station has been:-

Note: Cross out word or words which do not apply

1. Completely cleared to permit 360° vision to surrounding Trigs.
2. Cleared by lanes bearing ..... from Trig. Mast
3. The Trig. was ~~unpiled~~/not unpiled. dimensions now being:

Original Trig. Plug was ~~found~~/not found.

Length of Mast ..... feet (approximate if not unpiled) Mast (Round ..... feet diameter  
(Square ..... feet

Height of Trig. Plug ..... feet (above rock/concrete) Diameter of Vanes (vertical) ..... feet

Height of Top Vanes to Top Trig. Plug ..... feet Diameter of Cairn ..... feet


Height of Cairn ..... feet

(If other type Trig. beacon is erected - Diagram is required below in Remarks)

4. Trig. Mast & Vanes have been painted white & black respectively.
5. An S.S.M. set in conc/rock has been placed ..... feet bearing .....° M to Trig. Mast/Plug
6. A G.I. Pipe set in conc/soil has been placed ..... feet bearing .....° M to Trig. Mast/Plug
7. Connection S.S.M. to G.I. Pipe ..... feet bearing .....° M

REMARKS:- (To include diagram of marks placed)

North

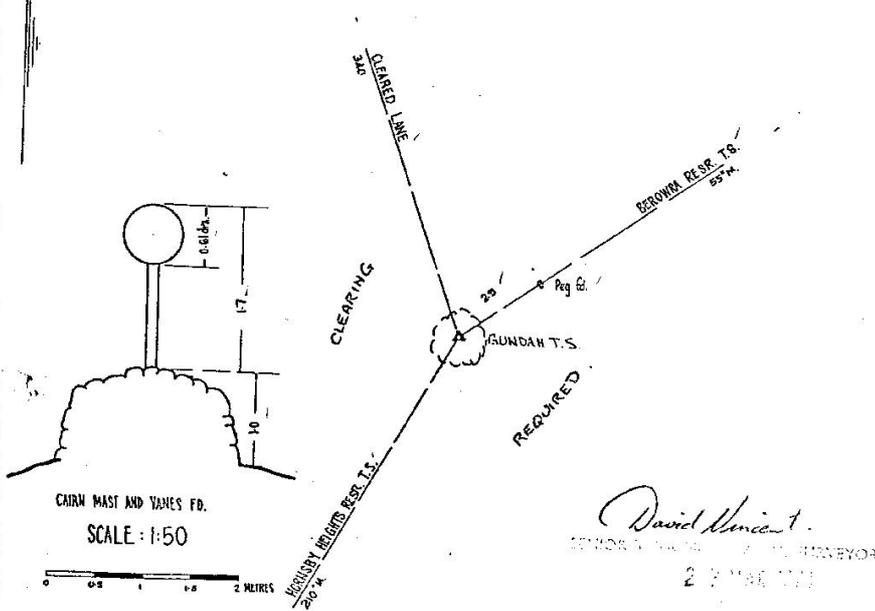

CHIEF SURVEYOR: MICHAEL MORRIS

Signature: [Signature]

