

GEODETTIC SURVEY OF NS/IK

CENTRAL MAPPING AUTHORITY

GEODETTIC STATION RECONNAISSANCE and MAINTENANCE REPORT

STATION: **GONDAHL G.S.** No.: **2359**

MAP SHEET SCALE 1:250 000  
INSPECTED BY: **J. Fanning** DATE: **31st August 19**

AUTHORITY: **C.M.A.** FIELD BOOK: **1765**

Description: *Note: Cross out word or words which do not apply*

- Cleared by lanes bearing... *Surrendered by trees*..... from Trig, Mast
  - Mast & Vanes have been painted white & black respectively.
  - The station ~~pillar~~ *was unplaced/not unplaced/reconstructed* on *31st Aug 1979*, dimensions now being: Description of mark..... should be explicit, e.g., S/Steel Pillar Plate, Steel plug, Brass plug, Bolt, G.I. Pipe
- Height of mark..... m. above below rock/concrete; Mark is..... m. above below G.L.
- Height of Top Vanes to Top Mark/Pillar plate ..... m. Diameter of Vanes (vertical)..... m.
- Height of Cairn..... m. Diameter of Cairn..... m. Name Plate ~~found~~ not found/placed.
- Length of Mast ..... m. (approximate if not unplaced)
4. A..... *No witness marks found*..... set in conc/rock has been placed/found, bearing..... ° M from Mast/Plug/Pillar
5. A..... set in conc/rock has been placed/found, bearing..... ° M from Mast/Plug/Pillar
6. A..... set in conc/rock has been placed/found, bearing..... ° M from Mast/Plug/Pillar
7. A..... set in conc/rock has been placed/found, bearing..... ° M from Mast/Plug/Pillar
8. Action required: ~~mark~~ *mark* ~~unplaced~~ *unplaced* ~~marks~~ *marks* ~~unplace~~ *unplace* for geodimeter work  
*1 day clearing for 2 necessary lines*

STANDPOINT:

Mark	Grid Direction	Horiz. Distance	Height Difference	Direction	Horiz. Distance	Height Difference
<i>Hills Sighted</i>			above standpt.			above standpt.
<i>Copanahurst</i>	53°		below			below
<i>Tackadger</i>	74°		above standpt.			above standpt.
<i>Remorie</i>	79°		below			below
<i>Caglebung</i>	244		above standpt.			above standpt.
<i>Lemon</i>	257		below			below
<i>Cargi East</i>	311		above standpt.			above standpt.
			below			below

Prepared by: *J. Fanning* Checked: *W. F. 2/9/79* Noted on U.T.M. Card

Station Diagram: A grid with Easting (210-250) and Northing (140-180) coordinates. A central crosshair is marked with a '+'.



MAP SHEET SCALE 1:250 000  
INSPECTED BY: **J. Fanning** DATE: **31st August 19**  
AUTHORITY: **C.M.A.** FIELD BOOK: **1765**

STATION: **GONDAHL G.S.** No.: **2359**

MAP SHEET SCALE 1:250 000  
INSPECTED BY: **J. Fanning** DATE: **31st August 19**

AUTHORITY: **C.M.A.** FIELD BOOK: **1765**

GEODETTIC SURVEY OF N.S.W.

CENTRAL MAPPING AUTHORITY

GEODETTIC STATION RECONNAISSANCE and MAINTENANCE REPORT

STATION: <b>GUNDAHL GS</b>	No.: <b>2359</b>
MAP SHEET SCALE 1:250 000 <b>GRAFTON</b>	
INSPECTED BY: <b>H. C. BORDER</b>	DATE: <b>12-10-19</b>
AUTHORITY: <b>C. M. A</b>	FIELD BOOK: <b>1680</b>


Description: **234<sup>m</sup>** *Note: Cross out word or words which do not apply*  
 1. Cleared by lanes bearing **64<sup>m</sup>** ..... from Trig. Mast

2. Mast & Vanes have been painted white & black respectively.

3. The station/~~marker~~ was unpiled/~~not unplaced/connected~~ on **12-10-19** ..... dimensions now being:  
 Description of mark **Brass Plug** should be explicit, e.g., S/Steel Pillar Plate, Steel plug, Brass plug, Bolt, G.I. Pipe  
 Height of mark **0.020<sup>m</sup>** above ~~mark~~/concrete; Mark is **0.360<sup>m</sup>** below G.L.  
 Height of Top Vanes to Top Mark/~~Plate~~ **4.200<sup>m</sup>** Diameter of Vanes (vertical) **0.915<sup>m</sup>**  
 Height of Cairn **1.600<sup>m</sup>** Diameter of Cairn ..... Name Plate ~~found~~/not found/~~placed~~  
 Length of Mast **4.270<sup>m</sup>** (approximate if not unpiled)

4. A ..... set in conc/rock has been placed/ found, bearing ..... M from Mast/Plug/Pillar  
 5. A ..... set in conc/rock has been placed/ found, bearing ..... M from Mast/Plug/Pillar  
 6. A ..... set in conc/rock has been placed/ found, bearing ..... M from Mast/Plug/Pillar  
 7. A ..... set in conc/rock has been placed/ found, bearing ..... M from Mast/Plug/Pillar  
 8. Action required: **to be repiled (Trig. left in place. For disambiguation.)** .....

STANDPOINT:					
Mark	Direction	Horiz. Distance	Height Difference	Direction	Horiz. Distance
			above standpt.		
			below standpt.		
			above standpt.		
			below standpt.		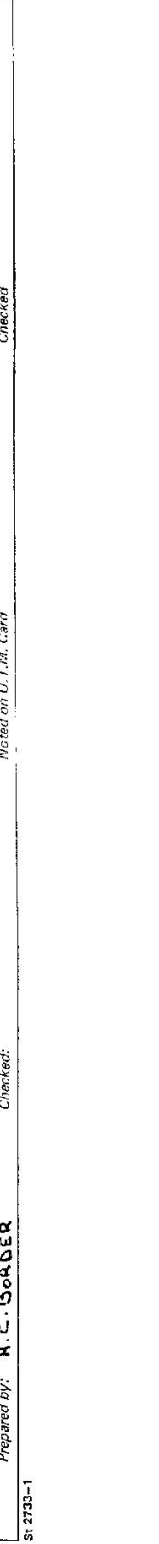
Prepared by: **H. C. BORDER** Checked: **Checked**  
 Noted on U.T.M. Card

STATION **GUNDAHL GS TS 2359**

Owner's Name: **REX THOMPSON**  
 Address: **OBAN PROPERTY**  
**JACKADGERY**  
 Phone: **(066) 47 46 53**

Current Occupant:  
 Address:  
 Phone:

ACCESS **12-10-1979**  
**From MANN RIVER SERVICE STATION JACKADGERY travel east towards -**  
**- Grafton**

Access Report of **31/3/1979** was found ~~unsuitable~~ suitable.  
**4. W. D**


**Cross Jackadgerie Creek.**  
**Turn right through iron gate into track,**  
**Turn left into faint track.**  
**Cross gully.**  
**Wooden gate.**  
**Iron gate.**  
**Wooden bridge.**  
**Wooden gate. C.M.A. lock.**  
**Follow track around to the left along creek, crossing creek 9 times**

**Blazed trees, turn right & follow track up ridge (steep)**  
**Pass through old log dump area, - keep left**  
**Keep right**  
**Pass through old log dump area.**  
**Blazed trees, take track to right.**  
**Dig. (ring tracks are faint near top of ridge and overgrown.)**  
**(make sure lucky off times)**

**OWNERS HOUSE**  
**0.0 AS BEFORE**  
**CONTINUE ALONG MAIN ROAD**  
**3.30 OWNERS HOUSE**  
**R.H.S**

**Record of Station**

Beacon Diagram Not to Scale

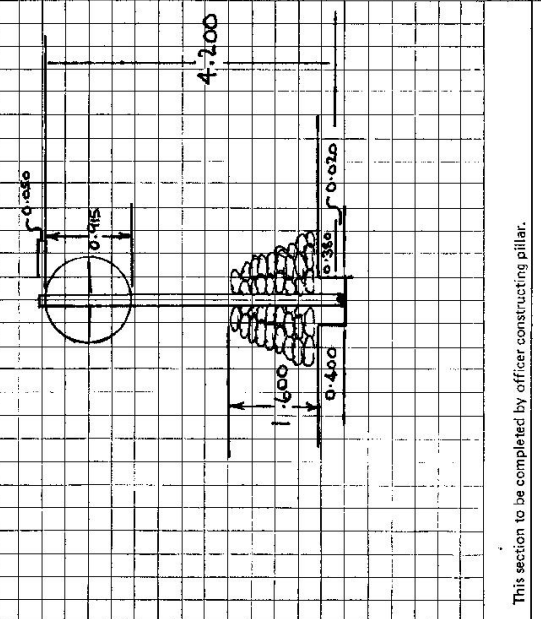

This section to be completed by officer constructing pillar.

Original station mark found/~~not found~~.  
 Description of mark: **BRASS TIE PLUG**  
 Original beacon found/~~not found~~.  
 Description of beacon: **CAIRN MAST and VANES**  
 Height Top of Vanes to Top Mark: **4.200** m.  
 Height of mark: **0.070** m. above ~~rock/conc~~ **0.400** m. above G.L. below  
 Diameter of Vanes: **0.915** m. Height of Cairn: **1.600** m.  
 Original Beacon ~~has~~ has not been destroyed by me.

GEODETIC SURVEY OF INS.W

CENTRAL MAPPING AUTHORITY

GEODETIC STATION RECONNAISSANCE and MAINTENANCE REPORT

- Description: \_\_\_\_\_
- Note: Cross out word or words which do not apply
- Cleared by lances bearing..... from Trig. Mast
  - Mast & Vanes have been painted white & black respectively.
  - The station/mast was ~~replaced~~ ~~reconstructed~~ on 27/3/80 dimensions now being: 19.80 m. above G.L.
- Description of mark ~~base~~ ~~plate~~ should be explicit, e.g., S/Steel Pillar Plate, Steel plug, Brass plug, Bolt, G.I. Pipe
- Height of mark 0.02 m. ~~rock~~/concrete; Mark is ~~above~~ below G.L.
- Height of Top Vanes to Top Mark/~~Plate~~ 3.71 m. Diameter of Vanes (vertical) 2.5 m.
- Height of Cairn 0.7 m. Diameter of Cairn 1.5 m. Name Plate found/not found/~~placed~~.
- Length of Mast \_\_\_\_\_ m. (approximate if not unplied)
- A..... set in conc/rock has been placed/found, bearing.....° M from Mast/Plug/Pillar
  - A..... set in conc/rock has been placed/found, bearing.....° M from Mast/Plug/Pillar
  - A..... set in conc/rock has been placed/found, bearing.....° M from Mast/Plug/Pillar
  - A..... set in conc/rock has been placed/found, bearing.....° M from Mast/Plug/Pillar
8. Action required.....

STANDPOINT:

Mark	Direction	Horiz. Distance	Height Difference	Mark	Direction	Horiz. Distance	Height Difference
			above standpt.				above standpt.
			below standpt.				below standpt.
			above standpt.				above standpt.
			below standpt.				below standpt.
			above standpt.				above standpt.
			below standpt.				below standpt.
			above standpt.				above standpt.
			below standpt.				below standpt.

Prepared by: G. J. 75

Checked: G. J. 75

Noted on U.T.M. Card

8:2733-1

STATION: GUNDAMH G.S. No.: 2359

MAP SHEET SCALE 1:250 000

INSPECTED BY: G. J. 75 DATE: 27-3-80

AUTHORITY: CMA FIELD BOOK: 1805V

Station Diagram

North

Not to Scale

M/B

CAIRN REPILED

MAST SHARP ENED


Checked

STATION **GUNDAHL TS 2359**

Owner's Name: .....  
 Address: .....  
 Phone: .....

Current Occupant: .....  
 Address: .....  
 Phone: .....

ACCESS  
 Access Report of...../19.....was found suitable/unsuitable.

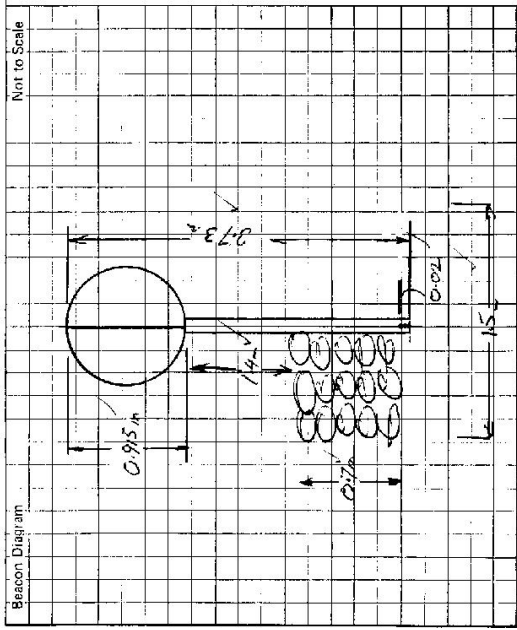

This section to be completed by officer constructing pillar.

Original station mark found/not found. ....  
 Description of mark: .....  
 Original beacon found/not found. ....  
 Description of beacon: .....  
 Height Top of Vanes to Top Mark.....m.  
 Height of mark.....m. above G.L. below  
 Diameter of Vanes.....m. Height of Cairn.....m.  
 Original Beacon has/has not been destroyed by me.

Date	Record of Station