

GEODETTIC SURVEY OF M.S.I.W

CENTRAL MAPPING AUTHORITY


GEODETTIC STATION RECONNAISSANCE and MAINTENANCE REPORT

STATION: SMA 0301 No.: 236

MAP SHEET SCALE 1:250 000 BEGA

INSPECTED BY: G. KEEP DATE: 22/5/80

AUTHORITY: FIELD BOOK:

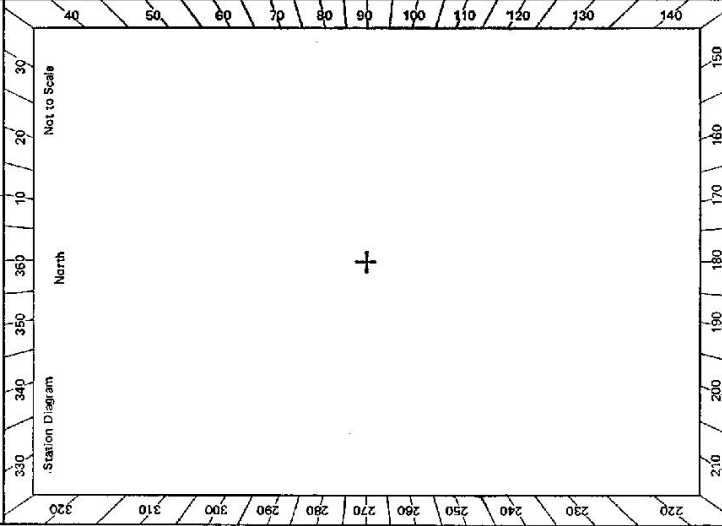

- Description:
- Note: Cross out word or words which do not apply
- Cleared by lanes bearing..... from T Fig. Mast
  - Mast & Vanes have been painted white & black respectively.
  - The station/pillar was unpiled/not unpiled/constructed on..... 19..... dimensions now being:
    - Description of mark..... should be explicit, e.g., S/Steel Pillar Plate, Steel plug, Brass plug, Bolt, G.I. Pipe
    - Height of mark.....m. <sup>above</sup> rock/concrete; Mark is.....m. <sup>above</sup> G.L., <sup>below</sup>
    - Height of Top Vanes to Top Mark/Pillar plate .....m. Diameter of Vanes (vertical).....m.
    - Height of Cairn.....m. Diameter of Cairn.....m. Name Plate found/not found/placed.
    - Length of Mast.....m. (approximate if not unpiled)
  - A.....set in conc/rock has been placed/found, bearing.....° M from Mast/Plug/Pillar
  - A.....set in conc/rock has been placed/found, bearing.....° M from Mast/Plug/Pillar
  - A.....set in conc/rock has been placed/found, bearing.....° M from Mast/Plug/Pillar
  - A.....set in conc/rock has been placed/found, bearing.....° M from Mast/Plug/Pillar
  - Action required:.....

STANDPOINT:			
Mark	Direction	Horiz. Distance	Height Difference
			above standpt
			below standpt
			above standpt
			below standpt
Prepared by: G. Keep 12/16/80

Checked

Noted on U.T.M. Card

C

STATION SMA 0301 TS 236	
Owner's Name: ..... Address: ..... Phone: .....	Current Occupant: ..... Address: ..... Phone: .....
Access Report of...../19.....was found suitable/unsuitable. Station not seen, condition unknown.	
ACCESS	
Not to Scale	
Beacon Diagram	
This section to be completed by officer constructing pillar.	
Original station mark found/not found.	
Description of mark: .....	
Original beacon found/not found.	
Description of beacon: .....	
Height Top of Vanes to Top Mark.....m. above below	
Height of mark.....m. above rock/cons.....m. below	
Diameter of Vanes .....m. Height of Cairn .....m.	
Original Beacon has/has not been destroyed by me.	
Date	Record of Station