

CENTRAL MAPPING AUTHORITY

Department of Lands

Trigonometrical Survey of N.S.W.

RECONNAISSANCE and MAINTENANCE REPORT

This Trig. Station has been:-

Note: Cross out word or words which do not apply

1. Completely cleared to permit 360° vision to surrounding Trig.

2. Cleared by lances bearing 320° - 100° M. from Trig. Mast

3. Trig. Mast & Vane have been painted white & black respectively.

4. The Trig. was unpiled / set unpiled, dimensions now being:

Description of mark..... 175 M. should be explicit, e.g. Steel plug, Brass plug, Bolt, G.I. Pipe

Height of mark..... 175 M. rock/concrete above below G.L.

Height of Top Vane to Top Mark..... m. Diameter of Vane (vertical)..... m.

Height of Cairn..... m. Diameter of Cairn..... m.

Length of Mast..... m. (approximate if not unpiled)

5. A..... set in conc/rock has been placed..... m. bearing..... °M from Trig. Mast

6. A..... set in conc/soil has been placed..... m. bearing..... °M from Trig. Mast

7. A..... set in conc/soil has been placed..... m. bearing..... °M from Trig. Mast

8. A..... set in conc/rock has been placed..... m. bearing..... °M from Trig. Mast

9. Connection..... to..... m. bearing..... °M

10. Connection..... to..... m. bearing..... °M

11. Connection..... to..... m. bearing..... °M

12. Connection..... to..... m. bearing..... °M

13. Diff. Ht. is..... m. above below

14. Diff. Ht. is..... m. above below

15. Diff. Ht. is..... m. above below

16. Diff. Ht. is..... m. above below

Prepared by: Alan Woodruff

Checked: J. Miller

Noted on U.T.M. Card

STATION

GLINGARLIN EAST G.S. TS 2372

Co: Ph:

Map Sheet: BERDALE

No: 8625 NORTH

Inspected by: A. WOODRUFF


Date: 22/1/77

Authority: CENTRAL MAPPING

Field Book: 1530

Beacon Diagram

Not to Scale

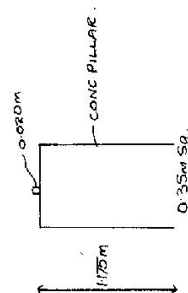

Date

Record of Station

TIMBER PUNDREDD HAS BEEN DESTROYED.
72 theodolite does not fit on Spigot.

Checked

Examined by A. Woodruff 27/3/79.

Current Occupant.....

Address.....


Owners Name.....

Address.....

Access
22-1-1977

From Indabyne travel towards Cooma - take road to Eumundene. Turn left about 5 kms past the Rocky Plains property and just after the power transmission lines. Cross the Eucumbene River. 1km further on take left turn. Follow track until you meet transmission line. With transmission lines running alongside follow track. Take track to right at transmission pylon M275. Go for approximately 1½ kms and come to a gate named Private Property. Go through and follow track to top of hill where you will see concrete trig pillar.

Refer to Bendale 1:100,000 sheet.)

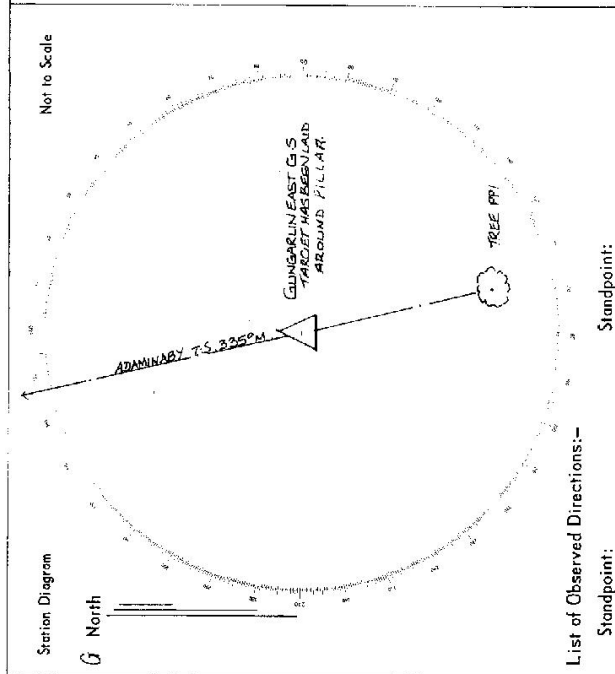

Station	Direction	Station	Direction
ADAMSWAY, TS	03° 00' 00"		
PP1 TREE	177° 58'		