

GEODETTIC SURVEY OF N.S.W.

CENTRAL MAPPING AUTHORITY

GEODETTIC STATION RECONNAISSANCE and MAINTENANCE REPORT

Description:

Note: Cross out word or words which do not apply

1. Cleared by lanes bearing..... from Trig. Mast
2. Mast & Vanes have been painted white & black respectively.
3. The station/pillar was ~~erected~~ <sup>found</sup> /constructed on..... <sup>to</sup>..... <sup>dimensions now being:</sup>
- Cairn of rocks
- Description of mark..... should be explicit, e.g., S/Steel Pillar Plate, Steel plug, Brass plug, Bolt, G.I. Pipe
- Height of mark.....m. <sup>above</sup> <sub>below</sub> rock/concrete; Mark is.....m. <sup>above</sup> <sub>below</sub> G.L.
- Height of Top Vanes to Top Mark/Pillar plate.....m. Diameter of Vanes (vertical).....m.
- Height of Cairn.....m. Diameter of Cairn.....m. Name Plate found/not found/placed.
- Length of Mast.....m. (approximate if not unplied)
4. A..... set in conc/rock has been placed/ found, bearing.....°M from Mast/Plug/Pillar
5. A..... set in conc/rock has been placed/ found, bearing.....°M from Mast/Plug/Pillar
6. A..... set in conc/rock has been placed/ found, bearing.....°M from Mast/Plug/Pillar
7. A..... set in conc/rock has been placed/ found, bearing.....°M from Mast/Plug/Pillar
8. Action required: ~~Mast & Vanes to be replaced~~ <sup>2 days cleaning to ground</sup>.....

STANDPOINT:

Mark	Direction	Horiz. Distance	Height Difference	Mark	Direction	Horiz. Distance	Height Difference
			above standpt				above standpt
			below				below
			above standpt				above standpt
			below				below
Prepared by: P.K. Bamola 14/5/79 Checked: *[Signature]*

Noted on U.T.M. Card

St. 2733-1

STATION: **GUNYAN** No.: **2381**  
 MAP SHEET SCALE 1:250 000 **CANBERRA**  
 INSPECTED BY: **P.K. Bamola** DATE: **June 1979**  
 AUTHORITY: **C.M.A** FIELD BOOK:

81-2738-2 D. West, Government Printer

STATION Guayah TS 2381


Beacon Diagram	Not to Scale
[A large grid area for drawing the beacon diagram, currently empty.]	

Owner's Name: .....  
 Address: .....  
 Phone: .....  
 Current Occupant: .....  
 Address: .....  
 Phone: .....

**ACCESS**

June 1979  
 Access Report of ...../19.....was found suitable/unsuitable.  
Refer Boro 1:25000 sheet

*A. A wheel drive vehicle can be driven from the gate at the end of the track, along the dotted line to the trig station*

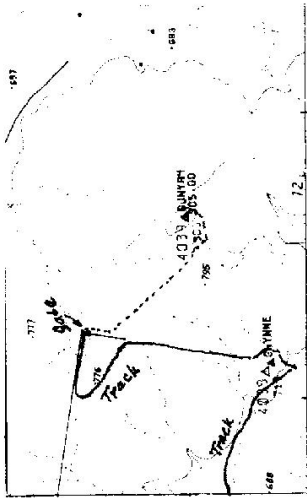

This section to be completed by officer constructing pillar.

Original station mark found/not found.

Description of mark: .....

Original beacon found/not found.

Description of beacon: .....

Height: Top of Varies to Top Mark: .....m.

Height of mark: .....m. above rock/conc .....m. below G.L.

Diameter of Vanes: .....m. Height of Cairn: .....m.

Original Beacon has/has not been destroyed by me.

Date

Record of Station
