

CENTRAL MAPPING AUTHORITY  
Department of Lands

Trigonometrical Survey of N.S.W.

RECONNAISSANCE ~~and RECONNAISSANCE~~ REPORT

This Trig. Station has been:-

Note: Cross out word or words which do not apply

1. Completely cleared to permit 360° vision to surrounding Trig.
2. Cleared by lanes bearing ..... from Trig. Mast
3. Trig. Mast & Vanes have been painted white & black respectively:-
4. The Trig. was unpiled/not unpiled, dimensions now being:

Description of mark..... Nat. Sects..... should be explicit, e.g. Steel plug, Brass plug, Bolt, G.I. Pipe  
 Height of mark..... m <sup>above</sup> rock/concrete ..... m <sup>below</sup> G.L.  
 Height of Top Vanes to Top Mark ..... m. Diameter of Vanes (vertical) ..... m.  
 Height of Cairn ..... m. Diameter of Cairn ..... m.  
 Length of Mast ..... m. (approximate if not unpiled)

5. A..... set in conc/rock has been placed..... m. bearing.....°M from Trig. Mast
6. A..... set in conc/soil has been placed..... m. bearing.....°M from Trig. Mast
7. A..... set in conc/soil has been placed..... m. bearing.....°M from Trig. Mast
8. A..... set in conc/rock has been placed..... m. bearing.....°M from Trig. Mast

9. Connection..... to..... m. bearing.....°M
10. Connection..... to..... m. bearing.....°M
11. Connection..... to..... m. bearing.....°M
12. Connection..... to..... m. bearing.....°M
13. Diff. Ht. .... is..... m. <sup>above</sup> <sub>below</sub>
14. Diff. Ht. .... is..... m. <sup>above</sup> <sub>below</sub>
15. Diff. Ht. .... is..... m. <sup>above</sup> <sub>below</sub>
16. Diff. Ht. .... is..... m. <sup>above</sup> <sub>below</sub>

Prepared by: K.S. HADAWAY 2-8-76

Checked: *[Signature]* 4/7/76

Noted on I.T.M. Card

2-4-96

STATION HALLETT S 2394

Co: CUMBERLAND PH: NORTH COAST

Map Sheet: SYDNEY No: 5130-N

Inspected by: K.J. HADAWAY Date: 23rd JULY 1976

Authority: G.M.A. Field Book:

Beacon Diagram Not to Scale

No Beacon

Date

Record of Station

Checked



Department of Lands

Central Mapping Authority

Trigonometrical Survey of N.S.W.

RECONNAISSANCE and MAINTENANCE REPORT on HALL TS 2394 TRIG. STATION

Parish NORTH COLA County CUMBERLAND Map Sheet ARCADIA 1:4000 I.S.G. No. 0075

Inspected by R.G. HANNA Date of Inspection 13TH JULY 1972

This Trig. Station has been:-


Note: Cross out word or words which do not apply

1. Completely cleared to permit 360° vision to surrounding Trigs.
2. Cleared by laser bearing..... from Trig. Mast
3. The Trig. was ~~unpiled~~/not unpiled, dimensions now being:
  - Original Trig. Plug was found/not found.
  - Length of Mast.....feet (approximate if not unpiled) Mast (Round.....feet diameter (Square.....feet
  - Height of Trig. Plug.....feet (above rock/concrete)
  - Height of Top Vanes to Top Trig. Plug.....feet Diameter of Vanes (vertical).....feet
  - Height of Cairn.....feet Diameter of Cairn.....feet

(If other type Trig. beacon is erected - Diagram is required below in Remarks)

4. Trig. Mast & Vanes have been painted white & black respectively.
5. An S.S.M. set in conc/rock has been placed.....feet bearing.....°M to Trig. Mast/Plug
6. A G.I. Pipe set in conc/soil has been placed.....feet bearing.....°M to Trig. Mast/Plug
7. Connection S.S.M. to G.I. Pipe.....feet bearing.....°M

REMARKS:- (To include diagram of marks placed)

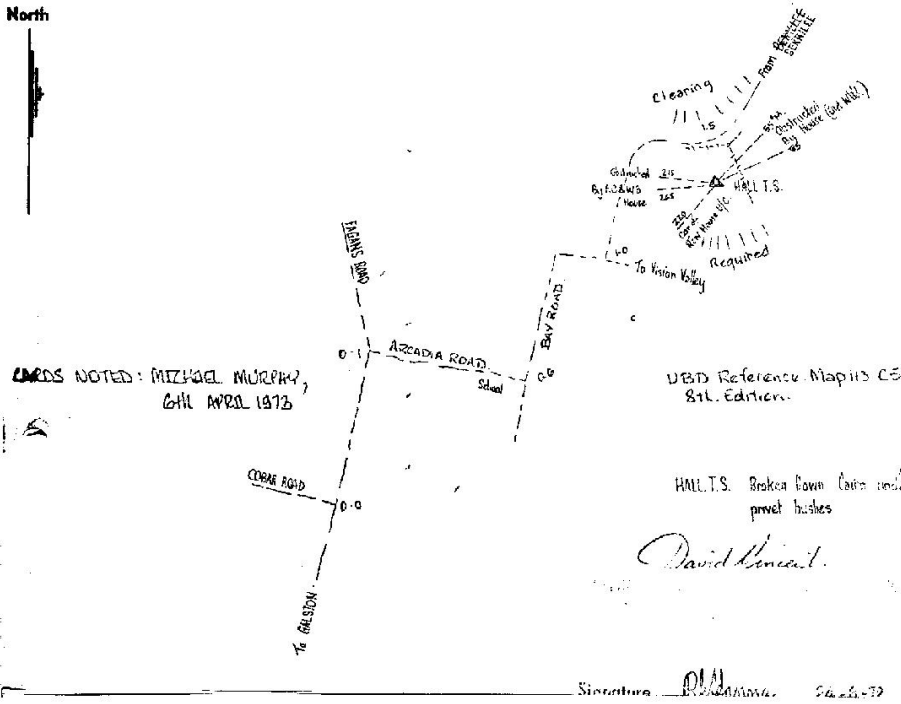

Department of Lands

TS. 2394

Central Mapping Authority

Trigonometrical Survey of N.S.W.

RECONNAISSANCE and MAINTENANCE REPORT on WILL TRIG. STATION

Parish North Colah County Cumberland Map Sheet Sydney North No. 9301

Inspected by H. Borden Date of Inspection \_\_\_\_\_

This Trig. Station has been:-

Note: Cross out word or words which do not apply

1. Completely cleared to permit 360° vision to surrounding Trigs.
2. Cleared by lanes bearing \_\_\_\_\_ from Trig. Mast
3. The Trig. was unplied/not unplied. dimensions now being:
 

Original Trig. Plug was found/not found.	
Length of Mast _____ feet (approximate if not unplied)	Mast (Round _____ feet diameter Square _____ feet)
Height of Trig. Plug _____ feet (above rock/concrete)	Diameter of Vanes (vertical) _____ feet
Height of Top Vanes to Top Trig. Plug _____ feet	Diameter of Cairn _____ feet

(If other type Trig. beacon is erected - Diagram is required below in Remarks)
4. Trig. Mast & Vanes have been painted white & black respectively.
5. An S.S.M. set in conc/rock has been placed \_\_\_\_\_ feet bearing \_\_\_\_\_ M to Trig. Mast/Plug
6. A G.I. Pipe set in conc/soil has been placed 8.00 feet bearing 167 M to Trig. Mast/Plug
7. Connection S.S.M. to G.I. Pipe \_\_\_\_\_ feet bearing \_\_\_\_\_ M

REMARKS:- (To include diagram of marks placed)

North

Trig Plug has been found and re-erected  
 in its original position (found loose in hole)  
 PM cover Box 30901 has been placed  
 over the plug.  
 Remains of cairn still surround the  
 mark while the rest of the trig reserve  
 is under cultivation.  
 1969 access of J. Judge still applies

Records noted

ER.

Signature

*J. Judge*