

TS 2401

Department of Lands
Integral Survey of N.S.W.
RECONNAISSANCE and MAINTENANCE REPORT 2401
STATION HAMMONDVILLE (P)
TS 2401

Co: _____ Ph: _____
Map Sheet: _____ No: _____
Inspected by: _____ Date: _____
Authority: _____ Field Book: _____
Beacon Diagram Not to Scale

This Trig. Station has been:-
1. Completely cleared to permit 360° vision to surrounding Trigs.
2. Cleared by lanes bearing _____ from Trig. Mast

Note: Cross out word or words which do not apply

STATION Hammondville Res. (centre) R.L. 46.40 (top of obs. plate)

To	R.L. (meters)	Direction or Vert. Angle	Variance	Dist. in metres (approx.)	Inst.	Observer	Date
See Reverse for location Diagram						J. N. Kelly 24th Nov. 1974	
						L.P. BIGGS	
						R.L. 42.40 (top of obs. plate)	

All directions corrected to centre
G 30
All Vert's corrected ground to ground
SEE REAR OF CARD FOR REMARKS

14. Diff. Ht. is m. above below
15. Diff. Ht. is m. above below
16. Diff. Ht. is m. above below


Prepared by: _____ Checked: _____

Date	Record of Station

STATION TS 2401 HAMMONDVILLE (P)

Owners Name.....
 Current Occupant.....
 Address.....
 Address.....
 Access.....

Not to Scale

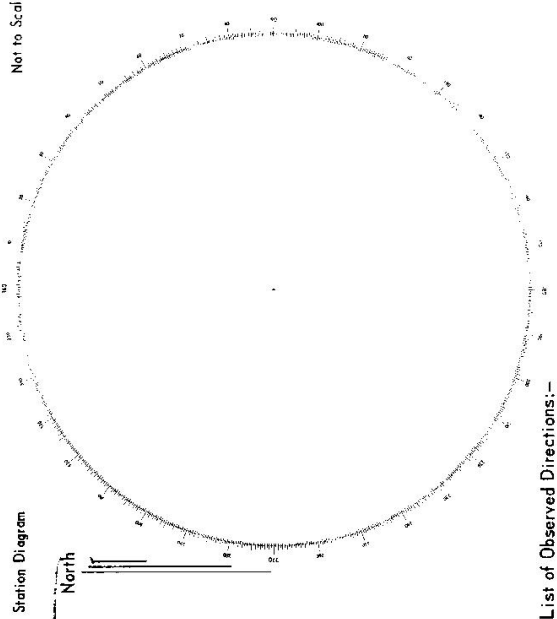

List of Observed Directions:-

Standpoint:		Station:	
Station	Direction	Station	Direction

STATION Hammondville Res. (centre) Remarks

