

CENTRAL MAPPING AUTHORITY
Department of Lands

Trigonometrical Survey of N.S.W.

RECONNAISSANCE and MAINTENANCE REPORT

This Trig. Station has been:-

Note: Cross out word or words which do not apply

1. Completely cleared to permit 360° vision to surrounding Trig. *Key recovered*
2. ~~Cleared by brass bearing~~ *Houses Bearing from 271° to 320° 342° to 440°* from Trig. Mast
3. Trig. Mast & Vanes have been painted white & black respectively *Height 281m, Centre of Mast 235m*
4. The Trig. was ~~unpiled~~/not unpiled, dimensions now being:

Description of mark..... should be explicit, e.g. Steel plug, Brass plug, Bolt, G.I. Pipe
 Height of mark..... m above rock/concrete m below G.I.
 Height of Top Vanes to Top Mark..... m. Diameter of Vanes (vertical) *1.006*..... m.
 Height of Cairn..... m. Diameter of Cairn *1.006*..... m.
 Length of Mast *3.316* m. (approximate if not unpiled)


5. A..... set in conc/rock has been placed..... m. bearing..... °M from Trig. Mast
6. A..... set in conc/soil has been placed..... m. bearing..... °M from Trig. Mast
7. A..... set in conc/soil has been placed..... m. bearing..... °M from Trig. Mast
8. A..... set in conc/rock has been placed..... m. bearing..... °M from Trig. Mast

9. Connection..... to..... m. bearing..... °M
10. Connection..... to..... m. bearing..... °M
11. Connection..... to..... m. bearing..... °M
12. Connection..... to..... m. bearing..... °M
13. Diff. Ht. is..... m. above below
14. Diff. Ht. is..... m. above below
15. Diff. Ht. is..... m. above below
16. Diff. Ht. is..... m. above below

Prepared by: *ML Morrison* Checked: _____ Noted on U.T.M. Card

STATION *HARRINGTON* TS *2417*
 Co: *MACQUARIE* Ph: *HARRINGTON*
 Map Sheet: *CAMDEN HAVEN* No: *5434*
 Inspected by: *ML Morrison* Date: *19/7/77*
 Authority Field Book: *1580*

Beacon Diagram Not to Scale

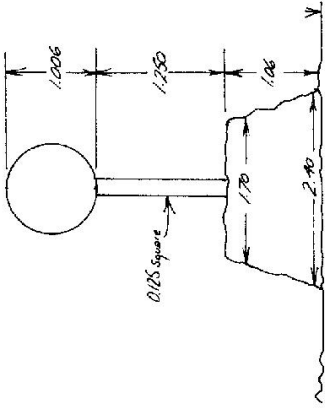

Date

Record of Station
This FD is used under No other names FD.

Checked

