

CENTRAL MAPPING AUTHORITY

GEODETIC SURVEY OF N.S.W.

GEODETIC STATION RECONNAISSANCE and MAINTENANCE REPORT

STATION: HARRIS No.: 2420

MAP SHEET SCALE 1:250 000 CANBERRA

INSPECTED BY: G. C. HANNA DATE: 23/4/79

AUTHORITY: C.M.A. FIELD BOOK:

- Description:
- Note: Cross out word or words which do not apply
- Cleared by lanes bearing..... from Trig. Mast
 - Mast & Vanes have been painted white & black respectively.
 - The station/pillar was unpiled/not unpiled/constructed on..... 19..... dimensions now being:
Description of mark..... should be explicit, e.g. S/Steel Pillar Plate, Steel plug-Brass plug, Bolt, G.I. Pipe
Height of mark.....m. above rock/concrete; Mark is.....m. above G.L.
Height of Top Vanes to Top Mark/Pillar plate.....m. Diameter of Vanes (vertical).....m.
Height of Cairn.....m. Diameter of Cairn.....m. Name Plate found/not found/placed.
Length of Mast.....m. (approximate if not unpiled)
 - A..... set in conc./rock has been placed/found, bearing.....°M from Mast/Plug/Pillar
 - A..... set in conc./rock has been placed/found, bearing.....°M from Mast/Plug/Pillar
 - A..... set in conc./rock has been placed/found, bearing.....°M from Mast/Plug/Pillar
 - A..... set in conc./rock has been placed/found, bearing.....°M from Mast/Plug/Pillar
 - Action required:.....


STANDPOINT:

Mark	Direction	Horiz. Distance	Height Difference	Mark	Direction	Horiz. Distance	Height Difference
			above standpt.				above standpt.
			below				below
			above standpt.				above standpt.
			below				below
Prepared by: G. Hanna 8/5/79 Checked:

Noted on U.T.M. Card

Sr 2733-1

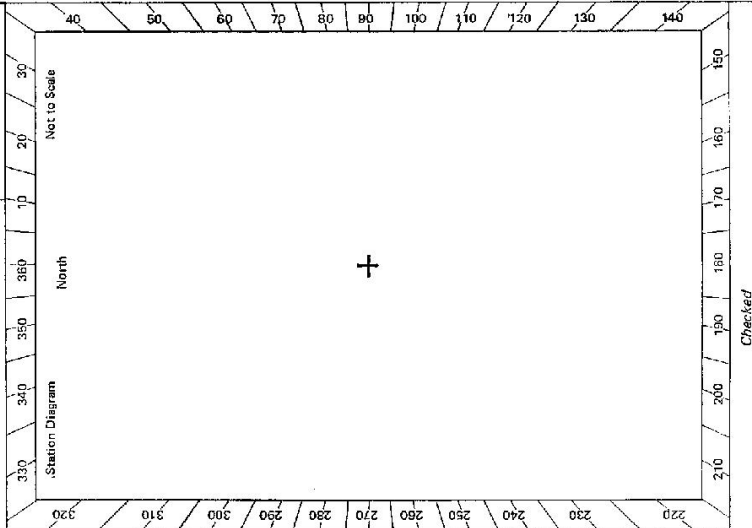

8: 2753-2 D. West, Government Printer

STATION **HARRIS IS 2420**

Owner's Name:

Address:

Phone:

Current Occupant:

Address:

Phone:

Access Report of 13/4/1979 was found suitable/unsuitable.

ACCESS

0.5 m cairn found
20 minute walk through medium density undergrowth
Medium to heavy clearing required

For further information see Manar 8827 - III - N

Date	Record of Station	Not to Scale

This section to be completed by officer constructing pillar.

Original station mark found/not found.

Description of mark:

Original beacon found/not found.

Description of beacon:

Height Top of Vane to Top Mark m.

Height of mark m. above G.L.
 m. below

Diameter of Vane m. Height of Cairn m.

Original Beacon has/has not been destroyed by me.