

CENTRAL MAPPING AUTHORITY  
Department of Lands

Trigonometrical Survey of N.S.W.

RECONNAISSANCE and MAINTENANCE REPORT

STATION **HARTLEY** Ph: **TS 24-24**

This Trig. Station has been:-

Note: Cross out word or words which do not apply

Co: **KATOOMBA** No: **8930**  
 Inspected by: **HARTLEY** Date:  
 Authority: **KATOOMBA** Field Book:  
 Beacon Diagram: **Not to Scale**

1. Completely cleared to permit 360° vision to surrounding Trigs.
2. Cleared by lances bearing..... from Trig. Mast
3. Trig. Mast & Vanes have been painted white & black respectively.
4. The Trig. was unpiled/not unpiled, dimensions now being: Original Station Mark found (not found)

Description of mark: **A** **rock** **wooden** **glued** should be explicit, e.g. Steel plug, Brass plug, Belt, G.I. Pipe

Height of mark..... m <sup>above</sup> rock/concrete <sup>below</sup> ..... m <sup>above</sup> G.L. <sup>below</sup>

Height of Top Vanes to Top Mark ..... m. Diameter of Vanes (vertical) ..... m.

Height of Cairn ..... m. Diameter of Cairn ..... m.

Length of Mast ..... m. (approximate if not unpiled)

5. A..... set in conc/rock has been placed..... m. bearing.....°M from Trig. Mast
6. A..... set in conc/soil has been placed..... m. bearing.....°M from Trig. Mast
7. A..... set in conc/soil has been placed..... m. bearing.....°M from Trig. Mast
8. A..... set in conc/rock has been placed..... m. bearing.....°M from Trig. Mast

9. Connection..... to..... m. bearing.....°M

10. Connection..... to..... m. bearing.....°M

11. Connection..... to..... m. bearing.....°M

12. Connection..... to..... m. bearing.....°M

13. Diff. Ht. .... is..... m. <sup>above</sup> <sup>below</sup>

14. Diff. Ht. .... is..... m. <sup>above</sup> <sup>below</sup>

15. Diff. Ht. .... is..... m. <sup>above</sup> <sup>below</sup>

16. Diff. Ht. .... is..... m. <sup>above</sup> <sup>below</sup>

Date **1930** Record of Station

**Station established**

Noted on U.T.M. Card

Checked:

Prepared by:

Checked




TS 2424  
HARTLEY

### LOCALITY SKETCH PLAN

Parish ..... County ..... City or Town .....  
 Municipality or Shire ..... Control Survey Plan LITHGOW 41990

Measurements are in metres

Zone ...../.....

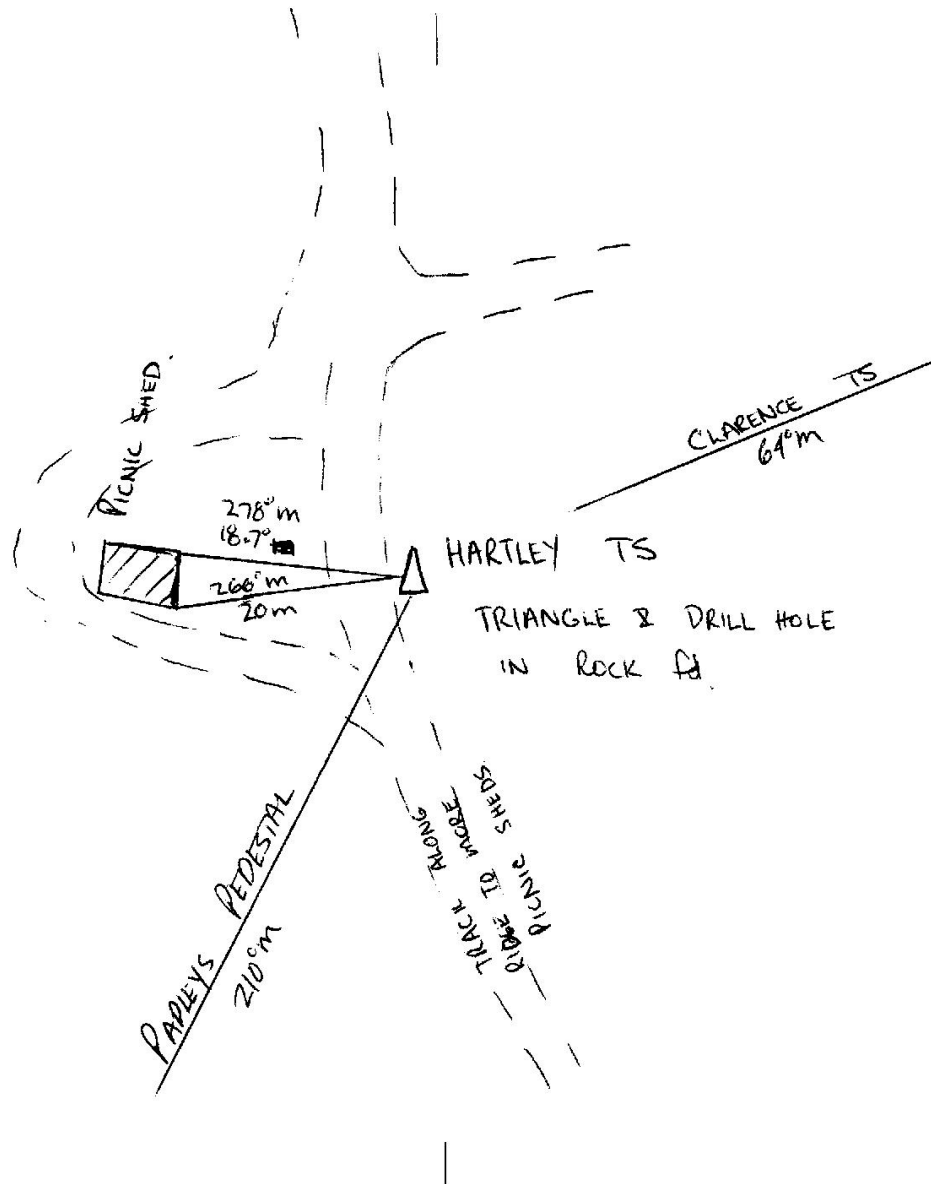

Organization placing Marks

I certify that the Mark or Marks have been placed and numbered as detailed hereon.

Aerial photo No. .... Run .....  
 Plan registered / / 19

PM .....  
 SSM .....