

CENTRAL MAPPING AUTHORITY

GEODETIC SURVEY OF N.S.W.

GEODETIC STATION RECONNAISSANCE and MAINTENANCE REPORT

STATION: HARVEY

No.: 2426

Description:

1. Cleared by lanes bearing..... 150° to 240° M
Note: Cross out word or words which do not apply
2. Mast & Vanes have been painted white & black respectively.
3. The station/~~marker~~ was unspiled/~~constructed~~ on..... 55.6 19.7 70 , dimensions now being:
 Description of mark..... should be explicit, e.g., S/Steel Pillar Plate, Steel plug, Brass plug, Bolt, G.I. Pipe
 Height of mark..... m. ^{above} rock/concrete; Mark is..... m. ^{above} G.L.
 Height of Top Vanes to Top Mark/~~Plate~~..... 3.61 m. Diameter of Vanes (vertical)..... 1.0 m.
 Height of Cairn..... 1.0 m. Diameter of Cairn..... m. Name Plate ~~found/not found/placed~~.
 Length of Mast..... 3.63 m. (approximate if not unspiled)
4. ~~A..... set in conc/rock has been placed/found, bearing..... m from Mast/~~plug/pillar~~~~
5. A..... set in conc/rock has been placed/found, bearing..... m from Mast/~~plug/pillar~~
6. A..... set in conc/rock has been placed/found, bearing..... m from Mast/~~plug/pillar~~
7. A..... set in conc/rock has been placed/found, bearing..... m from Mast/~~plug/pillar~~
8. ~~Action required:~~

MAP SHEET SCALE 1:250 000


S1 S5-V2

INSPECTED BY: G. HISSEY

DATE: FEB 78

AUTHORITY: SOIL CONSERVATION SERVICE

FIELD BOOK: 156

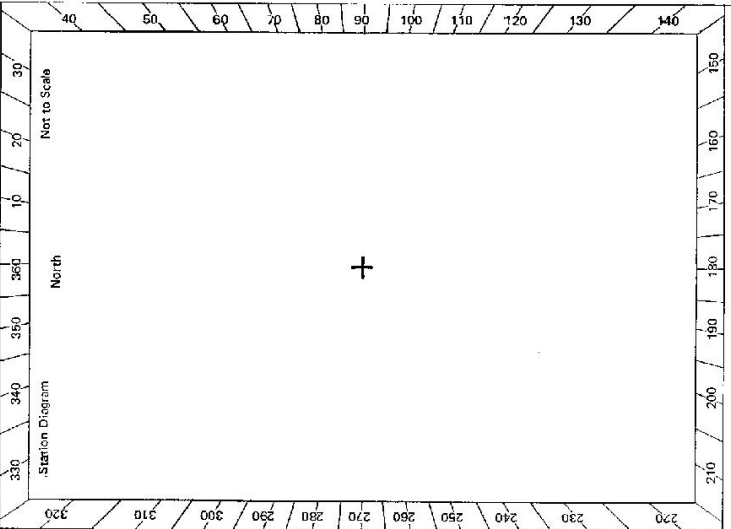

STANDPOINT:							
Mark	Direction	Horiz. Distance	Height Difference	Mark	Direction	Horiz. Distance	Height Difference
			above standpt.				above standpt.
			below standpt.				below standpt.
			above standpt.				above standpt.
			below standpt.				below standpt.
			above standpt.				above standpt.
			below standpt.				below standpt.
			above standpt.				above standpt.
			below standpt.				below standpt.

Prepared by: _____

Checked: _____

Noted on U.T.M. Grid

SI 2733-1

Sr.2735-2 D. West, Government Printer


STATION HARVEY TS 2426

Beacon Diagram	Not to Scale
[Grid area for drawing]	

Owner's Name:
 Address:
 Phone:

Current Occupant:
 Address:
 Phone:

Feb 1978
 ACCESS
 Access Report of 10/10/1978 found station to be stable.

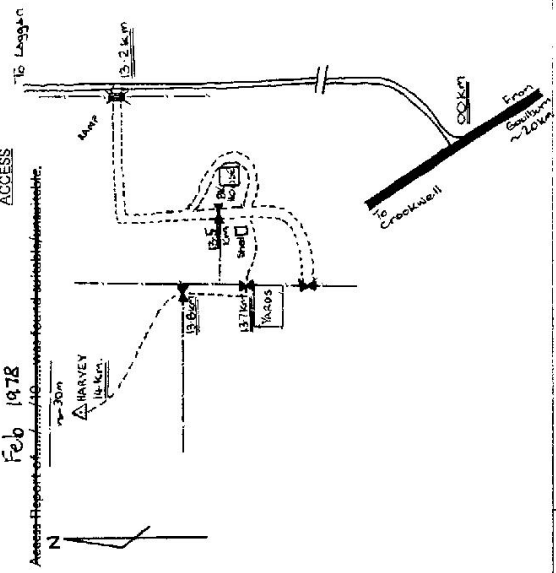

Date

Record of Station

This section to be completed by officer constructing pillar.

Original station mark found/not found.

Description of mark:

Original beacon found/not found.

Description of beacon:

Height Top of Vanes to Top Mark.....m.

Height of mark.....m. above G.L. below rock/conc.....m.

Diameter of Vanesm. Height of Cairnm.

Original Beacon has/has not been destroyed by me.