

Department of Lands Integrating Survey of N.S.W.

RECONNAISSANCE and MAINTENANCE REPORT

This Trig. Station has been:- Note: Cross out word or words which do not apply

1. ~~Completely cleared to permit 360° vision to surrounding Trig.~~
2. Cleared by lones bearing 183.1 228.1 335.1 from Trig. Mast
3. Trig. Mast & Vanes have been painted white & black respectively. ✓
4. The Trig. was unpiled/~~not unpiled~~, dimensions now being:
 - Description of mark ~~STEEL PILLAR~~ should be explicit, e.g. Steel plug, Brass plug, Bolt, Concrete Pillar
 - Height of mark 1.16 m above ~~mark~~ concrete 1.24 m above G.L.
 - Height of Top Vanes to Top Mark Top pillar plate 1.25 m Diameter of Vanes (vertical) 0.6 m.
 - Height of Cairn 0.8 m Diameter of Cairn 2.4 m.
 - Length of Mast 1.33 m. (approximate if not unpiled)


5. ~~APPLY (was) set in conc./rock has been placed~~ fd 3.423 m. bearing 293.0°M from Trig. Mast/pillar
6. ~~A STAINLESS STEEL PIN set in concrete~~ has been placed ~~to~~ 3.825 m. bearing 340.0°M from Trig. Mast/pillar
7. ~~APPLY (was) set in concrete~~ has been placed ~~to~~ 7.216 m. bearing 13.0°M from Trig. Mast/pillar
8. ~~A SSN 30226 set in conc./rock has been placed~~ fd 4.507 m. bearing 49.0°M from Trig. Mast/pillar

9. Connection to m. bearing°M
10. Connection to m. bearing°M
11. Connection to m. bearing°M
12. Connection to m. bearing°M
13. Diff. Ht. ~~STAINLESS STEEL PIN~~ 1.157 m. ~~below~~ PILLAR PLATE } AFTER 02/238
14. Diff. Ht. SSN 30226 is 1.220 m. ~~above~~ PILLAR PLATE } KENNEDY CROSS
15. Diff. Ht. SSN 30226 is 0.913 m. ~~above~~ STAINLESS STEEL PIN } LEVELLING.
16. Diff. Ht. is m. ~~above~~ ~~below~~

Prepared by: R. LANDLER Checked: *DL*

STATION HARVEY T.S. 2427 (1)
 Co: CUMBERLAND Pt: BROKEN BAY
 Map Sheet: TERREBY HILLS U1867 No:
 Inspected by: H.C. BORDER Date: 16/83
 Authority LANDS DEPT. Field Book: 20247

Beacon Diagram Not to Scale

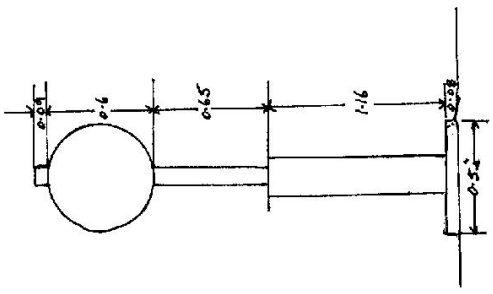

Date	Record of Station
16-3-77	STEEL PILLAR, MAST & VANE REPAIRED
16-1-83	SURVEY

