

GEODETTIC SURVEY OF N.S.W. Batch Id 1608

CENTRAL MAPPING AUTHORITY

GEODETTIC STATION RECONNAISSANCE and MAINTENANCE REPORT

Description:

Note: Cross out word or words which do not apply

1. Cleared by lanes bearing..... from Trig. Mast
2. Mast & Vanes have been painted white & black respectively.
3. The station/pillar was unpiled/hot unpiled/constructed on.....19....., dimensions now being:
Description of mark.....should be explicit, e.g., S/Steel Pillar Plate, Steel plug, Brass plug, Bolt, G.I. Pipe
Height of mark.....m. above below rock/concrete; Mark is.....m. above below G.L.
Height of Top Vanes to Top Mark/Pillar plate.....m. Diameter of Vanes (vertical).....m.
Height of Cairn.....m. Diameter of Cairn.....m. Name Plate found/not found/placed.
Length of Mast.....m. (approximate if not unpiled)
4. A. P.M. 54539.....set in conc/feak has been placed/removed/lost, bearing.....212.....°M from Mast/Plug/Pillar
5. A. C.U. Nail.....set in conc/feak has been placed/removed/lost, bearing.....323.....°M from Mast/Plug/Pillar
6. A. SSM 13842.....set in conc/feak has been placed/removed/lost, bearing.....111.....°M from Mast/Plug/Pillar
7. A.....set in conc/rock has been placed/removed/lost, bearing.....°M from Mast/Plug/Pillar
8. Action required:.....

STANDPOINT: Pillar Plate

STANDPOINT: P.M. 54539

Mark	Direction	Horiz. Distance	Height Difference	Mark	Direction	Horiz. Distance	Height Difference
WARRAGOSS (P)	0° 00' 00" 0		above standpt.	WARRAGOSS (P)	0° 00' 00" N		above standpt.
LINDEN	3° 29' 08" 0		above standpt.	C.U. Nail in Conc	226° 15' 42"	44.40	below standpt.
BLUE MTN	23° 45' 42" 0		above standpt.	SSM 13842	245° 00' 54"	54.349	below standpt.
C.U. Nail in Conc	84° 51' 42" 0 (Support)		above standpt.	HAWKESBURY ROAD EXP.	226° 06' 14"	25.812	above standpt.
P.M. 54539	338° 58' 25"		below standpt.	SCOTT TOWER	226° 13' 56" 2		below standpt.
			above standpt.				above standpt.
			below standpt.				below standpt.


Prepared by: *Kingsley*

Noted on U.T.M. Card

S4 2733-1

Checked:

Checked

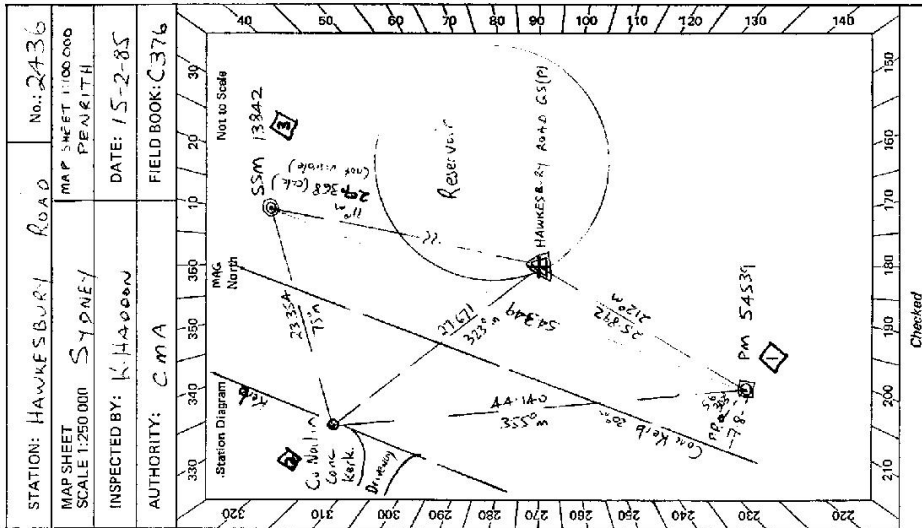

STATION: HAWKESBURY ROAD No: 2436

MAP SHEET SCALE 1:250,000 PEARRITH

INSPECTED BY: K. HARRISON DATE: 15-2-85

AUTHORITY: C.M.A. FIELD BOOK: C376

STATION **HAWKESBURY ROAD TS 2436**

Owner's Name: **M. W. S. D. B.**
 Address:
 Phone:

Current Occupant:
 Address:
 Phone:
ACCESS
 Access Report of **18/01/18** was found suitable/unsuitable.

Beacon Diagram

Not to Scale

This section to be completed by officer constructing pillar.

Original station mark found/not found.

Description of mark:

Original beacon found/not found.

Description of beacon:

Height Top of Vanes to Top Mark:m.

Height of mark:m. above G.L.
below rock/conc.

Diameter of Vanesm. Height of Calmm.

Original Beacon has/has not been destroyed by me.

STANDPOINT: Cul. Dial. in loc.

Mag	Dist	Mag	Dist	Record of Station
MAAV	000'00"			
SCOT TOWER	000'00"			
SSM 13842	71° 06' 00"	23.800	0.206 mls. 600	
HAWKESBURY ROAD	140° 47' 24"	27.671	17.883 mls. 600	
PM 54539	174° 00' 46"			