
						74
GEODETIC STATI	GEODETIC STATION RECONNAISSANCE and MAINTENANCE REPORT	Nd MAINTEN	ANCE REP	ORT	STATION: HAYES	No.: 2451
Description: 1. Cleared by lanes bearing	Note: Cross out word or words which do not apply from Tria. Mast	ords which do from Tric	not apply 1. Mast	# 6		KA
Mast & Vanes have been painted white & black respectively.	ely.					
The station/pillar was unpiled/not unpiled/constructed on	on. Not Found 19	., dimensions n	iow being:		330 340 LANG	FIELD BOOK:
Description of markshould be explicit, e.g., S/Steel Pillar Plate, Steel plug, Brass plug, Bolt, G.I. Pipe	i.g., S/Steel Pillar Plate, Stee	el plug, Brass p	lug, Bolt,	G.I. Pipe	ion Diagram	Not to Sca
Height of markm.m.m.m. <sup>ebowe</sup> rock/concrete;	Mark is	ove G.L.				
Height of Top Vanes to Top Mark/Pillar plate		Diameter of Vanes (vertical)m.	cal)	.ш		
Height of CairnDiameter o	Diameter of Cairnm. Ma	Name Plate found/not found/placed.	d/not four	d/placed.	018	
Length of Mastm				2	00	
A	ed/found, bearing°	VI from Mast/	Plug/Pillar		νε /	
A	ad/found, bearing <sup>9</sup> fi	Vi from Mast/	Plug/Pillar		06ž /	
Aset in conc/rock has been placed/found, bearing	ad/found, bearing°N	M from Mast/Plug/Pillar	Pluq/Pillar		OŞZ	
7. A	d/found, bearing	M from Mast/Plug/Pillar	Plug/Pillar		+	
8. Action required:						
	STANDPOINT:			1	s /	
Direction Horiz. Height Difference	Mark	Direction	Horiz. Distance	Height Difference	) ş <del>ç</del> (	
ebove standpt below standpt	ťá			above standpt.	540	
abave standpt. below				below standpt		
above standpt. below	Dr.			above below standpt.	,530	
above standat. below			2	above standpt.		
above standpt.	to.			above standpt.		
above standpt. below					, 250	
above standpt.	31.			above below standpt.	210 / 200 / 190   190	1/10 160 150
Cillin 21.1.70 Checked:		Noto	Motod on 11 T 14 Cana	Canal C		

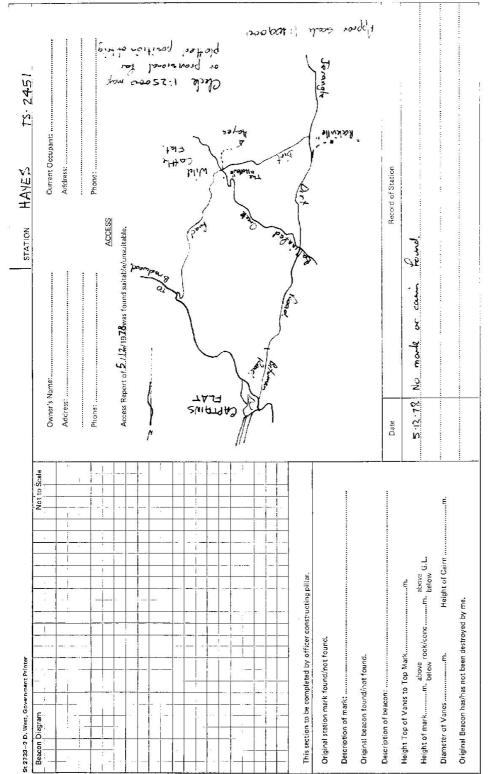

e e