

LAND INFORMATION CENTRE

GEODETTIC SURVEY OF N.S.W.

GEODETTIC STATION RECONNAISSANCE and MAINTENANCE REPORT

STATION: **HIGHEST POINT** TS No.: **2480**

MAP SHEET SCALE 1:250 000 **GOULBURN**

INSPECTED BY: **G. FORD** DATE: **31/1/91**

AUTHORITY: **L. I. C.** FIELD BOOK: **2103**

Description:

Note: Cross out word or words which do not apply

1. Cleared by vanes bearing... **292° - 305° 37' - 89° 22' - 104° 13' - 145° 22'** from Trig. Mast
228° - 252°
2. Mast & Vanes have been painted white & black respectively.
3. The station/pillar was unpiled/not unpiled/constructed on... **19**....., dimensions now being:
LEAD PLUG IN DRILL HOLE IN ROCK

Description of mark..... should be explicit, e.g., S/Steel Pillar Plate, Steel plug, Brass plug, Bolt, G.I. Pipe

Height of mark.....m. ^{above} rock/concrete; Mark is.....m. ^{above} G.L. _{below}

Height of Top Vanes to Top Mark/Pillar plate.....m. Diameter of Vanes (vertical).....m.

Height of Cairn.....m. Diameter of Cairn.....m. Name Plate found/not found/placed.


Length of Mast.....m. (approximate if not unpiled)

4. A. **SSM 51227**.....set in conc/rock has been placed/found, bearing... **35** °M from Mast/Plug/Pillar
5. A.....set in conc/rock has been placed/found, bearing..... °M from Mast/Plug/Pillar
6. A.....set in conc/rock has been placed/found, bearing..... °M from Mast/Plug/Pillar
7. A.....set in conc/rock has been placed/found, bearing..... °M from Mast/Plug/Pillar

8. Action required:.....

STANDPOINT:				STANDPOINT:			
Mark	Direction	Horiz. Distance	Height Difference	Mark	Direction	Horiz. Distance	Height Difference
			above standpt.				above standpt.
			below				below
			above standpt.				above standpt.
			below				below
Prepared by: **A Ford 6/2/91** Checked: **DF** Noted on U.T.M. Card

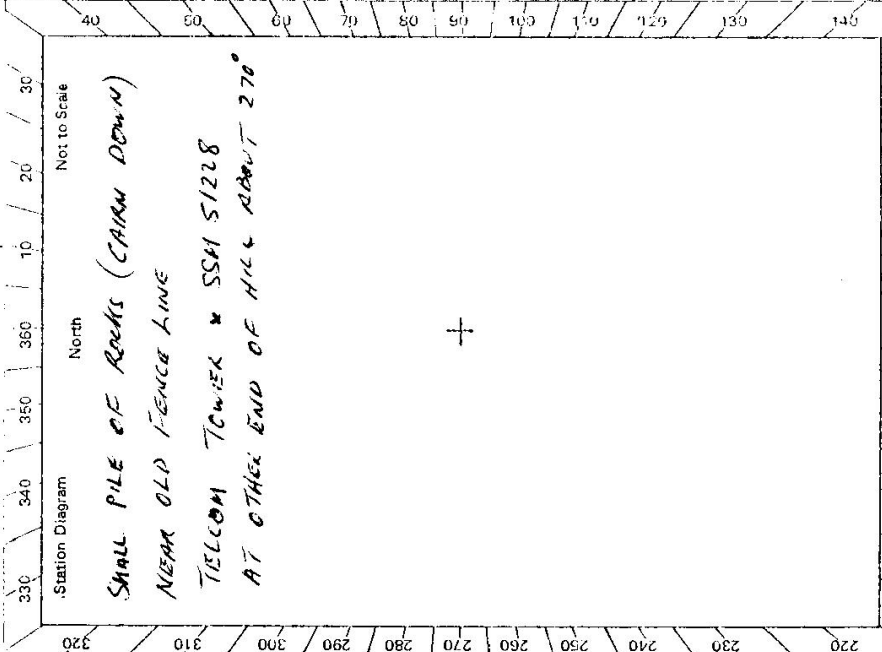

Checked

