

Department of Lands

Integration of N.S.W.

RECONNAISSANCE and MAINTENANCE REPORT 2486 C

STATION

HINCHINBROOK (P)

TS 2486

This Trig. Station has been:-

Note: Cross out words or words which do not apply

1. Completely cleared to permit 360° vision to surrounding Trigs.
2. Cleared by lances bearing _____ from Trig. Mast
3. Trig. Mast & Vanes have been painted white & black respectively.
4. The Trig. was unpiled/~~not completed~~, dimensions now being:

Description of mark: CONCRETE PILLAR should be explicit, e.g. Steel plug, Brass plug, Bolt, Concrete Pillar

Height of mark: _____ m above rock/concrete 1.35 m above G.L.

Height of Top Vanes to ~~Top Mast~~ Top pillar plate: 1.58 m Diameter of Vanes (vertical): 0.60 m.

Height of Cairn: _____ m. Diameter of Cairn: _____ m.

Length of Mast: 2.06 m. (~~approximate if not supplied~~)

5. A... GI PIPE set in conc/~~rock~~ has been placed/fd 3.100 m, bearing 253 °M from Trig. Mast/pillar
6. A... COPPER SPIKE set in conc/~~soil~~ has been placed/fd 3.075 m, bearing 359 °M from Trig. Mast/pillar
7. A... set in conc/~~soil~~ has been placed/fd _____ m, bearing _____ °M from Trig. Mast/pillar
8. A... set in conc/~~rock~~ has been placed/fd _____ m, bearing _____ °M from Trig. Mast/pillar

9. Connection: GI PIPE to COPPER SPIKE: 4.700 m, bearing 40 °M

10. Connection: _____ to _____: _____ m, bearing: _____ °M

11. Connection: _____ to _____: _____ m, bearing: _____ °M

12. Connection: _____ to _____: _____ m, bearing: _____ °M

13. Diff. Ht. GI PIPE is 1.336 m, ~~above~~ Pillar Plate

14. Diff. Ht. COPPER SPIKE is 1.149 m, ~~below~~ Pillar Plate

15. Diff. Ht. _____ is _____ m, ~~above~~ _____

16. Diff. Ht. _____ is _____ m, ~~above~~ _____

Prepared by: L. Hayes

Checked: S. H. J.

Map Sheet:

No:

Inspected by: L. M. HAYES


Authority: DEPT OF LANDS

Beacon Diagram

Date: 28-7-75

Field Book: GBL 37

Not to Scale

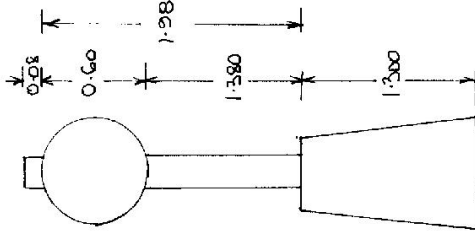

Date

11/177

Record of Station

C. Stratkey. Connection & pillar details unchanged.

STATION HINCHINBROOK (P) TS 2486


Owners Name: Current Occupant:

Address: Address:

Access: 28-7-1975
CONVENTIONAL VEHICLE ACCESS!

Not to Scale


Station Diagram

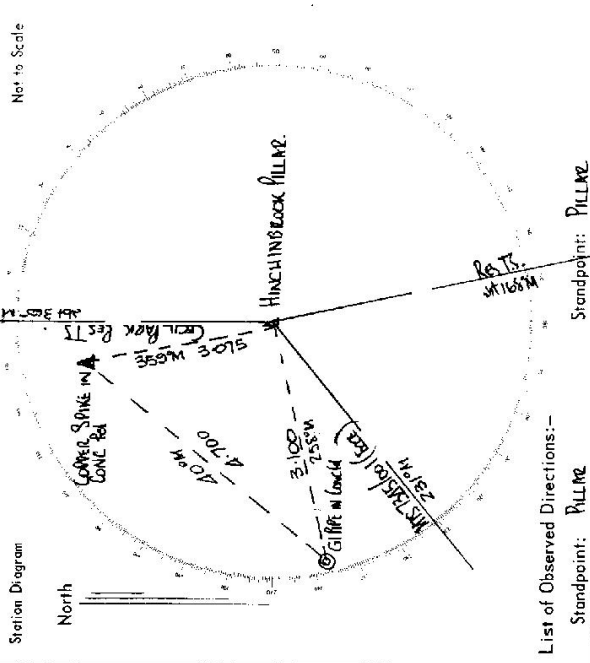

List of Observed Directions:-

Station	Direction	Station	Direction
CECIL PARK RES TR	355° 59' 60"	CECIL PARK RES TR	355° 59' 60"
RUBY RES TR	168° 03' 04"	GIPPE IN CONC RD	168° 03' 04"
MITS TRANSDUCT (ECC)	754° 19' 24"	CONCRETE SPINE IN CONC RD	754° 19' 24"


Station	Direction	Station	Direction

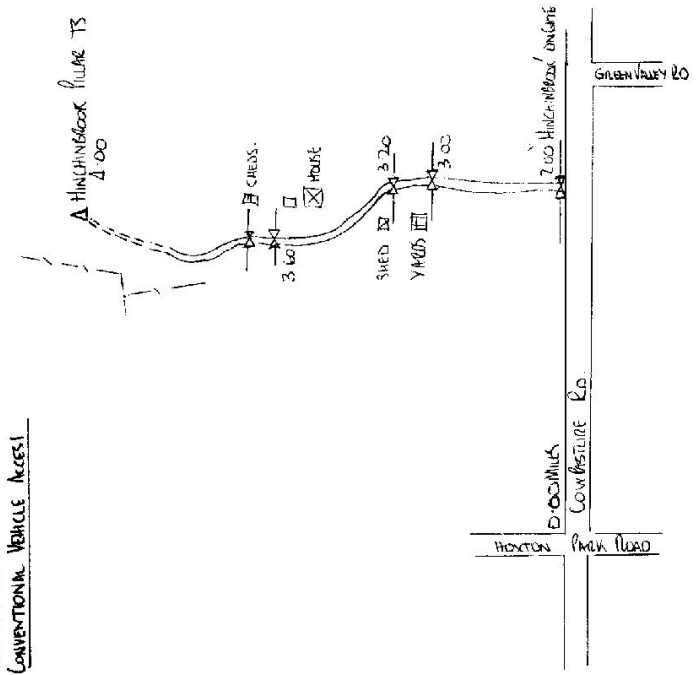

STATION 2486 HINCHINBROOK(TS)


Owners Name
 Current Occupant.....
 Address.....
 Address.....

Access 15-9-1978

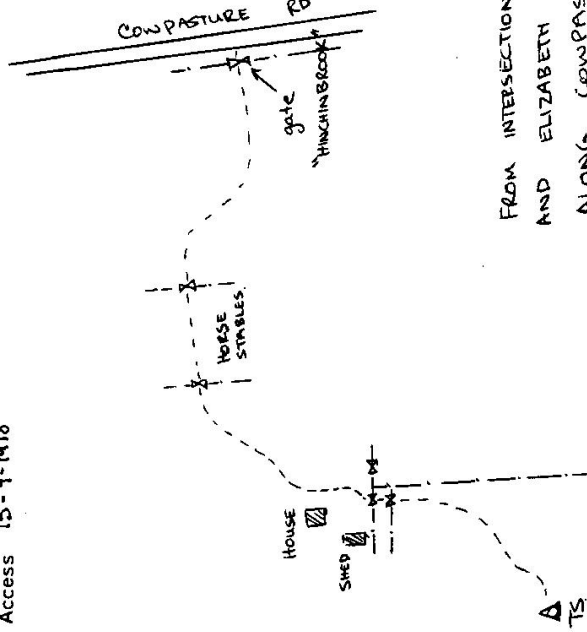

FROM INTERSECTION OF COMPASTURE RD AND ELIZABETH DRIVE TRAVEL STH ALONG COMPASTURE RD TO GATE ON RIGHT "HINCHINBROOK". FOLLOW ROAD TO HOUSE THEN TS.

Not to Scale

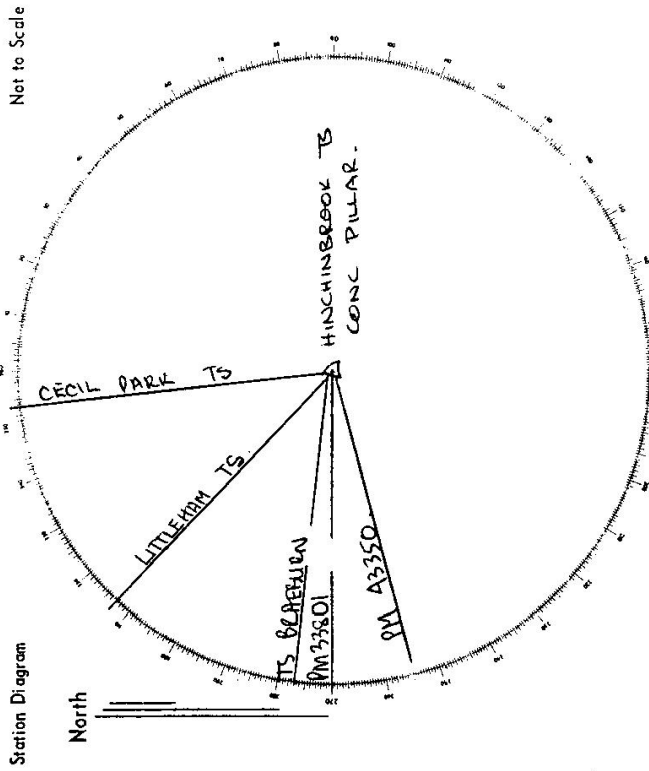

List of Observed Directions:-

Station	Direction	Station	Direction
0M A3350	255°00'00"	0M A33801	270°00'00"
CECIL PARK TS	354°25'23.9"	TS 2860 LITTLEHAM	319°57'02.2"
LITTLEHAM TS	312°26'05.3"	TS 1443 CECIL PARK	1°56'22.2"
		TS 10587 BRABERDEN	271°03'11.3"

Station	Direction	Station	Direction