

CENTRAL MAPPING AUTHORITY
 GEODETTIC SURVEY OF N.S.W.
 STATION: HINKLER TS
 MAP SHEET SCALE 1:250 000
 INSPECTED BY: S. GREENING
 AUTHORITY: D.M.R.
 DATE: 20.3.78
 FIELD BOOK:

See also Hinkler Pillar
 No: 2488

GEODETTIC STATION RECONNAISSANCE and MAINTENANCE REPORT

Description:
 1. Cleared by lanes bearing.....
 Note: Cross out word or words which do not apply
 2. Mast & Vanes have been painted white & black respectively. **(NB) SEE CARD for HINKLER PILLAR**
 3. The station/pillar was unpiled/not unpiled/constructed on.....
 Description of mark.....
 Height of mark.....
 Height of Top Vanes to Top Mark/Pillar plate.....
 Height of Cairn.....
 Length of Mast.....
 4. A.....
 5. A.....
 6. A.....
 7. A.....
 8. As soon required:.....

Note: Cross out word or words which do not apply from Trig. Mast
 from Trig. Mast
 dimensions now being:
 should be explicit, e.g., S/Steel Pillar Plate, Steel Plug, Brass plug, Bolt, G.I. Pipe
 rock/concrete; Mark is.....
 Diameter of Vanes (vertical).....
 Diameter of Cairn.....
 Name Plate found/not found/placed.
 (approximate if not unpiled)
 set in conc./rock has been placed/found, bearing.....
 set in conc./rock has been placed/found, bearing.....
 set in conc./rock has been placed/found, bearing.....
 set in conc./rock has been placed/found, bearing.....

STANDPOINT:			
Mark	Direction	Horiz. Distance	Height Difference
			above standpt.
			below standpt.
			above standpt.
			below standpt.
Prepared by:
 Checked:
 Accret on U.T.M. Card

GEODETTIC SURVEY OF M.S.W.

CENTRAL MAPPING AUTHORITY

GEODETTIC STATION RECONNAISSANCE and MAINTENANCE REPORT


- Description:**
 Note: Cross out word or words which do not apply
- Cleared by lanes bearing..... from Trig, Mast
 - Mast & Vanes have been painted white & black respectively.
 (not searched for) (not reported) (not repaired) (not constructed on)..... dimensions now being: 19.....
 - The station/pillar was unpiled/~~not unpiled~~..... should be explicit, e.g., S/Steel Pillar Plate, Steel plug, Brass plug, Bolt, G.I. Pipe
- Description of mark.....
 Height of mark.....m. ^{above} _{below} rock/concrete; Mark is.....m. ^{above} _{below} G.L.
- Height of Top Vanes to Top Mark/Pillar plate.....m. Diameter of Vanes (vertical).....m.
- Height of Cairn.....m. Diameter of Cairn.....m. Name Plate found/not found/placed.
- Length of Mast.....m. (approximate if not unpiled)
- A.....set in conc/rock has been placed/found, bearing.....° M from Mast/Plug/Pillar } no sat. marks fd
 - A.....set in conc/rock has been placed/found, bearing.....° M from Mast/Plug/Pillar } marks fd
 - A.....set in conc/rock has been placed/found, bearing.....° M from Mast/Plug/Pillar
 - A.....set in conc/rock has been placed/found, bearing.....° M from Mast/Plug/Pillar
8. Action required: 6. *slugs clearing new pillar. (abt 1 day clearing to beyond 65) (abt 5 days to Normford 65)*

STANDPOINT:

Mark	Direction	Horiz. Distance	Height Difference	Mark	Direction	Horiz. Distance	Height Difference
			above standpt.				above standpt.
			below				below
			above standpt.				above standpt.
			below				below
Prepared by: *J. Fanning* Checked: *6/5/17* Noted on U.T.M. Card

542733-1

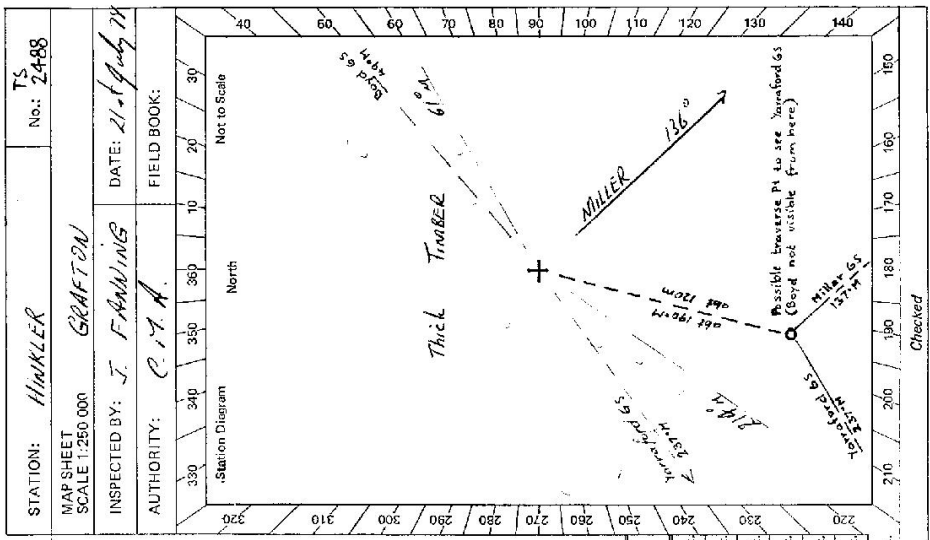

Checked

61 2735-2 D. West, Government Printer

STATION **HANKLER G.S. TS 2488**

Beacon Diagram

Not to Scale

Owner's Name: **J.W. Macquoid**
 Address: **P.O. Box 79**
 Phone: **DUNDEE 344 146**

Current Occupant:
 Address:
 Phone:

ACCESS 21-7-1978

Access Report of .../19 ... was found suitable/unusable:

Mrs
0 0 P.O. Glen Innes New England hwy NW
12 00 Pass rd to Kangaroo valley on left
15 00 Turn left off hwy. Road side new off hwy
15 23 Locked gate (on bottom fence wire to left of gate)
 or contact owner
 Through gate turn right across gully
15 67 Gate (Yellow track)
16 17 Iron Gate
16 95 G.S. HANKLER.

This section to be completed by officer constructing pillar.

Original station mark found/not found.

Description of mark:

Original beacon found/not found.

Description of beacon:

Height Top of Vane to Top Mark:m.

Height of mark:m. above
m. below G.L.

Diameter of Vane:m.

Height of Cairn:m.

Original Beacon has/has not been destroyed by me.

Date	Record of Station