

CENTRAL MAPPING AUTHORITY
Department of Lands

Trigonometrical Survey of N.S.W.

RECONNAISSANCE and MAINTENANCE REPORT

This Trig. Station has been:-

Note: Cross out word or words which do not apply

1. Completely cleared to permit 360° vision to surrounding Trigs.
2. Cleared by ~~lines bearing~~..... from Trig. Mast
3. Trig. Mast & Vanes have been painted white & black respectively.
4. The Trig. was unpiled/~~not unpiled~~, dimensions now being:

Description of mark..... should be explicit, e.g. Steel plug, Brass plug, Bolt, G.I. Pipe

Height of mark..... m above rock/concrete..... m below G.L.

Height of Top Vanes to Top Mark..... m. Diameter of Vanes (vertical)..... m.

Height of Cairn..... m. Diameter of Cairn..... m.

Length of Mast..... m. (approximate if not unpiled)

5. A..... set in conc/rock has been placed..... m. bearing.....°M from Trig. Mast
6. A..... set in conc/soil has been placed..... m. bearing.....°M from Trig. Mast
7. A..... set in conc/soil has been placed..... m. bearing.....°M from Trig. Mast
8. A..... set in conc/rock has been placed..... m. bearing.....°M from Trig. Mast

9. Connection..... to..... m. bearing.....°M
10. Connection..... to..... m. bearing.....°M
11. Connection..... to..... m. bearing.....°M
12. Connection..... to..... m. bearing.....°M

13. Diff. Ht. is..... m. above below
14. Diff. Ht. is..... m. above below
15. Diff. Ht. is..... m. above below
16. Diff. Ht. is..... m. above below

Prepared by: *[Signature]* 23/4/76 Checked: *[Signature]*

Noted on U.T.M. Card

STATION HOBBSGROFT TS 2490

Co: CECILIANA Ph: CIPERMANINA

Map Sheet: ABRACOMBIE No: 8730 110 III

Inspected by: Date:

Authority: Field Book:



Beacon Diagram: Net to Scale

No Cairn Found
ACCESS ONLY

Date: Record of Station

Date	Record of Station

Checked

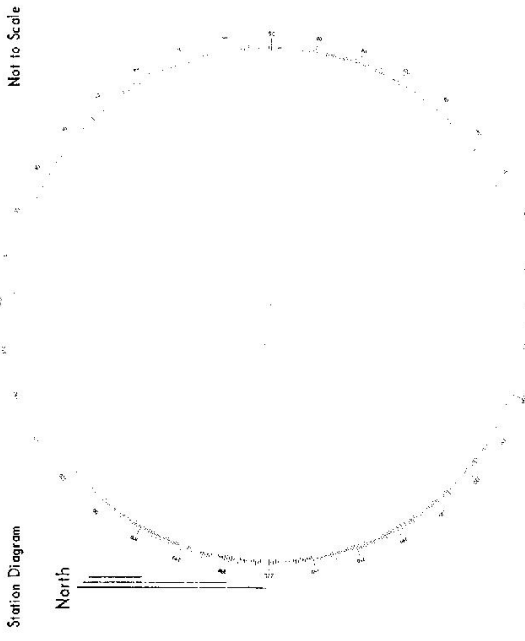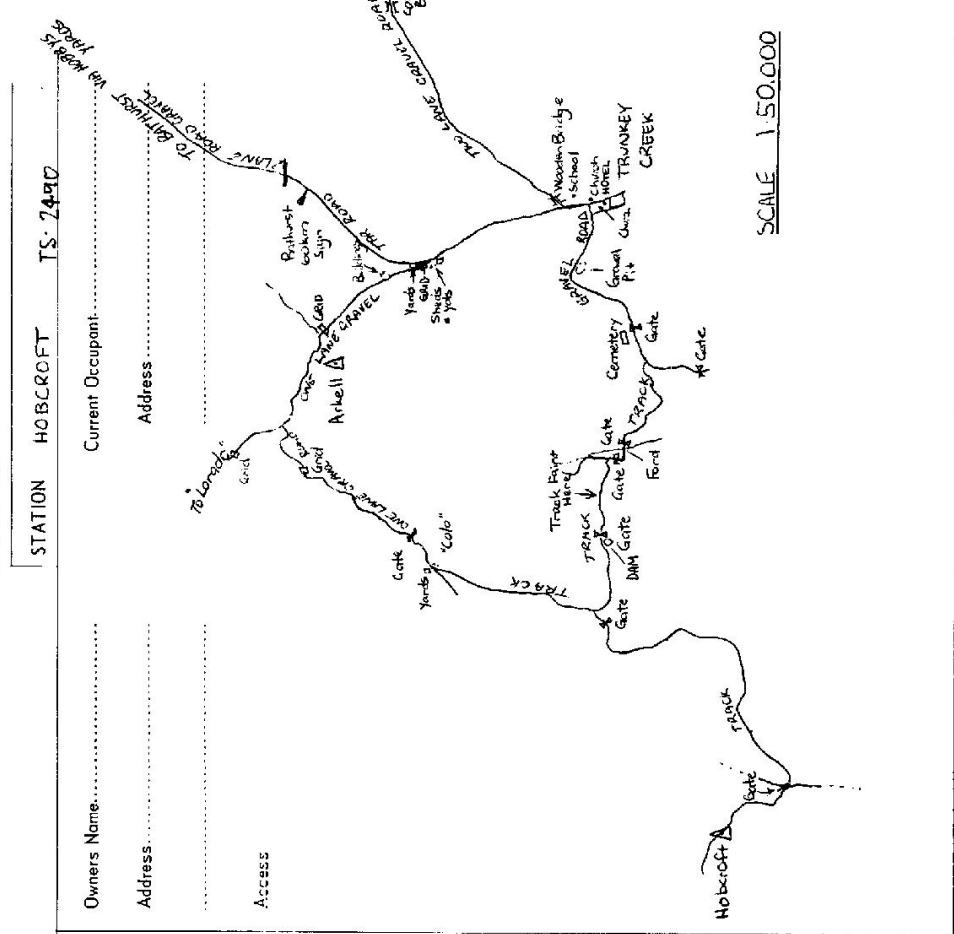

List of Observed Directions:-

Standpoint:

Station	Direction	Station	Direction
.....
.....
Station	Direction	Station	Direction
.....
.....
SCALE 1:50,000

CENTRAL MAPPING AUTHORITY

Department of Lands

Trigonometrical Survey of N.S.W.

RECONNAISSANCE and MAINTENANCE REPORT

This Trig. Station has been:-

Note: Cross out word or words which do not apply

1. Completely cleared to permit 360° vision to surrounding Trigs.
2. Cleared by lanes bearing..... from Trig. Mast
3. Trig. Mast & Vanes have been painted white & black respectively.
4. The Trig. was unpiled/not unpiled, dimensions now being:
 - Description of mark..... should be explicit, e.g. Steel plug, Brass plug, Bolt, G.I. Pipe

Height of mark..... m above rock/concrete..... m above G.L.
 below below

Height of Top Vanes to Top Mark..... m. Diameter of Vanes (vertical)..... m.

Height of Cairn..... m. Diameter of Cairn..... m.

- Length of Mast..... m. (approximate if not unpiled)
5. A..... set in conc/rock has been placed..... m. bearing.....°M from Trig. Mast
 6. A..... set in conc/soil has been placed..... m. bearing.....°M from Trig. Mast
 7. A..... set in conc/soil has been placed..... m. bearing.....°M from Trig. Mast
 8. A..... set in conc/rock has been placed..... m. bearing.....°M from Trig. Mast

9. Connection..... to..... m. bearing.....°M
10. Connection..... to..... m. bearing.....°M
11. Connection..... to..... m. bearing.....°M
12. Connection..... to..... m. bearing.....°M
13. Diff. Ht. is..... m. above below
14. Diff. Ht. is..... m. above below
15. Diff. Ht. is..... m. above below
16. Diff. Ht. is..... m. above below

Prepared by: W. J. G. L. Checked: Noted on U.T.M. Card

STATION HERBERT DEFERRE TS 2490

Co: CERRIGNIA Ph: CERRIGNIA

Map Sheet: BATHURST 1:250,000 No:

Inspected by: KILPATRICK Date: 18-5-76

Authority: C.M.A. Field Book:

Beacon Diagram Not to Scale

No beacon found

Date Record of Station

CENTRAL MAPPING AUTHORITY

Department of Lands

Trigonometrical Survey of N.S.W.

RECONNAISSANCE and MAINTENANCE REPORT

This Trig. Station has been:-

Note: Cross out word or words which do not apply

- 1. Completely cleared to permit 360° vision to surrounding Trigs.
- 2. Cleared by lanes bearing..... from Trig. Mast
- 3. Trig. Mast & Vanes have been painted white & black respectively.
- 4. The Trig. was unpiled/not unpiled, dimensions now being: ~~.....~~ ^{CONCRETE FOUND}

Description of mark..... should be explicit, e.g. Steel plug, Brass plug, Bolt, G.L. Pipe
 Height of mark..... m ^{above} / _{below} rock/concrete m ^{above} / _{below} G.L.
 Height of Top Vanes to Top Mark..... m. Diameter of Vanes (vertical)..... m.
 Height of Cairn..... m. Diameter of Cairn..... m.

- 5. A..... set in conc/rock has been placed..... m. bearing..... °M from Trig. Mast
- 6. A..... set in conc/soil has been placed..... m. bearing..... °M from Trig. Mast
- 7. A..... set in conc/soil has been placed..... m. bearing..... °M from Trig. Mast
- 8. A..... set in conc/rock has been placed..... m. bearing..... °M from Trig. Mast

- 9. Connection..... to..... m. bearing..... °M
- 10. Connection..... to..... m. bearing..... °M
- 11. Connection..... to..... m. bearing..... °M
- 12. Connection..... to..... m. bearing..... °M
- 13. Diff. Ht. is..... m. ^{above} / _{below}
- 14. Diff. Ht. is..... m. ^{above} / _{below}
- 15. Diff. Ht. is..... m. ^{above} / _{below}
- 16. Diff. Ht. is..... m. ^{above} / _{below}

Prepared by: *[Signature]*

Checked:

Noted on U.T.M. Card

STATION HIGHLIGHT TS 2490

Co: C.F. GILGIANA | Pts: CARPENTERMANNA

Map Sheet: BATHURST 1250 000 | No:

Inspected by: K. HARRISON | Date: 18-5-76

Authority: C.M.A. | Field Book:

Beacon Diagram Not to Scale

No beacon found

Date Record of Station

GEODETTIC SURVEY OF N.S.W.

CENTRAL MAPPING AUTHORITY

GEODETTIC STATION RECONNAISSANCE and MAINTENANCE REPORT

Description:


1. Cleared by Janes bearing.....*Note: Cross out word or words which do not apply*
 2. Mast & Vanes have been painted white & black respectively.
 3. The station/pillar was unpiled/not unpiled/constructed on.....19....., dimensions now being:
 Description of mark.....should be explicit, e.g., S/Steel Pillar Plate, Steel plug, Brass plug, Bolt, G.I. Pipe
 Height of mark.....m.....^{above} rock/concrete; Mark is.....m.....^{above} G.I.L.
 Height of Top Vanes to Top Mark/Pillar plate.....m..... Diameter of Vanes (vertical).....m.
 Height of Cairn.....m..... Diameter of Cairn.....m..... Name Plate found/not found/placed.
 Length of Mast.....m..... (approximate if not unpiled)
 4. A.....set in conc/rock has been placed/found, bearing.....°M from Mast/Plug/Pillar
 5. A.....set in conc/rock has been placed/found, bearing.....°M from Mast/Plug/Pillar
 6. A.....set in conc/rock has been placed/found, bearing.....°M from Mast/Plug/Pillar
 7. A.....set in conc/rock has been placed/found, bearing.....°M from Mast/Plug/Pillar
 8. Action required:.....*A.O. MARKS FOUND S.T.A. 1004 S.C.F.M.S. 473E*.....

STATION: *HORLROFT* No.: *2990*

MAP SHEET SCALE 1:250 000 *BATHURST*


INSPECTED BY: *A. CORRIE* DATE: *14-8-81*

AUTHORITY: *C.M.A.* FIELD BOOK: *1986*

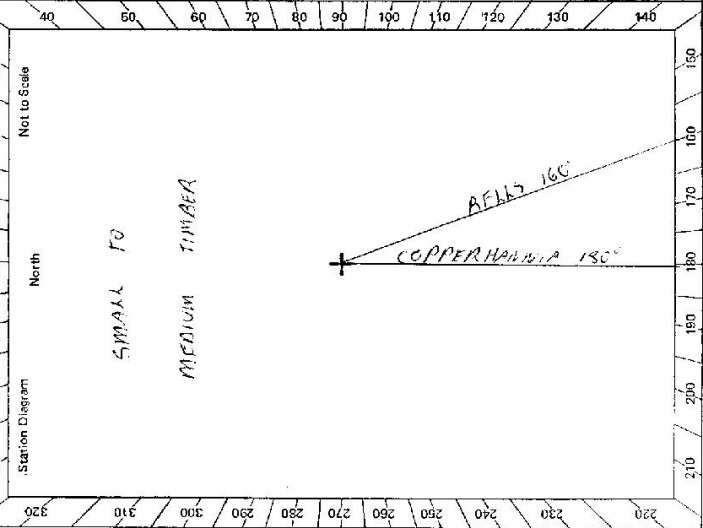

STANDPOINT:							
Mark	Direction	Horiz. Distance	Height Difference	Mark	Direction	Horiz. Distance	Height Difference
			above standpt.				above standpt.
			below standpt.				below standpt.
			above standpt.				above standpt.
			below standpt.				below standpt.
			above standpt.				above standpt.
			below standpt.				below standpt.
			above standpt.				above standpt.
			below standpt.				below standpt.

Prepared by:.....
 Checked:.....
 Noted on U.T.M. Card

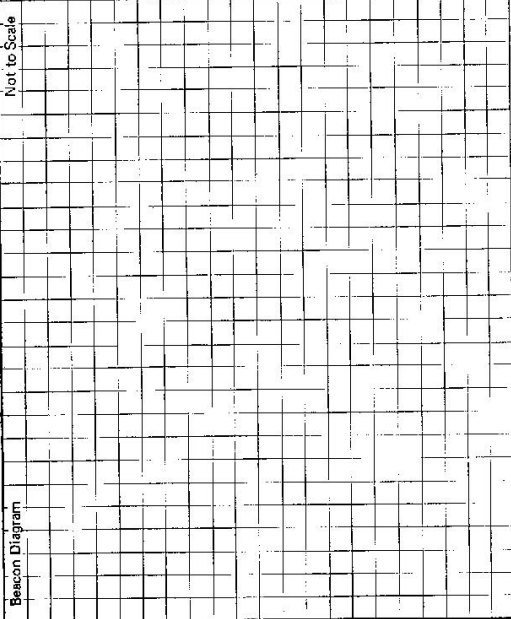

STATION **HORACROFT TS 2490**

OWNER'S NAME: **TRAFFIC ASSOCIATION 1994**
 ADDRESS: **NO. LEASE, BR. 055, 2/25, 235 + 365, AS. ST. 6/11/18**
 PHONE: **ACCESS 14-8-81**

ACCESS TRACK
 CURRENT OCCUPANT: **DR. I. K. M. J. J. J. J.**
 ADDRESS: **ISABELEY**
 PHONE: **ISABELEY 74**

Access Report of **18/12/19** was found suitable for use.

- FEATURE
- 0.0 TRUNKY PG HEAD TOWARDS ADJUNCT
 - 0.55 TAKE LEFT FOR TOWARDS ALABET
 - 2.25 TURN LEFT UP GRANEX RD
 - 235 + 365 GRID T-GATE
 - 4.95 TURN LEFT "COLD"
 - 5.5 GRID T-GATE "KIMMICK PARK"
 - 6.5 PASS TRACK ON LEFT
 - 6.9 IRON GATE "NO Stopping or Camping"
 - 7.2 PASS SHED + YARD ON RIGHT
 - 7.4 PASS WHITEHEADS HOUSE ON LEFT AND CONTINUE STRAIGHT AHEAD PASSING
 - 9.45 WIRE GATE
 - 11.9 PASS TRACK ON LEFT
 - 12.55 CROSS CREEK
 - 13.0 THROUGH GATEWAY AND FOLLOW TRACK TO RIGHT
 - 13.25 PASS WIRE GATE + TRACK ON RIGHT
 - 14.15 HORACROFT G.S. IN MIDDLE OF TRACK.

This section to be completed by officer constructing pillar.

Original station mark found/not found.

Description of mark:

Original beacon found/not found.

Description of beacon:

Height Top of Vanes to Top Mark:m.

Height of mark:m. above G.L.
 rock/bancm. below

Diameter of Vanes:m. Height of Cairn:m.

Original Beacon has/has not been destroyed by me.

Date	Record of Station