

CENTRAL MAPPING AUTHORITY
Department of Lands

Trigonometrical Survey of N.S.W.

RECONNAISSANCE and MAINTENANCE REPORT

STATION **HOLLOW ROCK** Ph: **TS-2497**

This Trig. Station has been:-

Co:

Map Sheet: **S4 ALBANS**

No: **9031**

Inspected by:

Date:

Authority:

Field Book:

Beacon Diagram **Not to Scale**

Note: Cross out word or words which do not apply

1. Completely cleared to permit 360° vision to surrounding Trigs.
2. Cleared by lanes bearing from Trig. Mast
3. Trig. Mast & Vanes have been painted white & black respectively.
4. The Trig. was unpiled/not unpiled, dimensions now being: *Original Mast: 100 ft. 6 in. 0.0000*
Description of mark: **Drill Hole in Rock + Beacon** should be explicit, e.g. Steel plug, Brass plug, Bell, G.I. Pipe
Height of mark m ^{above} rock/concrete m ^{below} G.L.
- Height of Top Vanes to Top Mark m. Diameter of Vanes (vertical) m.
- Height of Cairn m. Diameter of Cairn m.
- Length of Mast m. (approximate if not unpiled)
5. A set in conc/rock has been placed m. bearing °M from Trig. Mast
6. A set in conc/soil has been placed m. bearing °M from Trig. Mast
7. A set in conc/soil has been placed m. bearing °M from Trig. Mast
8. A set in conc/rock has been placed m. bearing °M from Trig. Mast
9. Connection to m. bearing °M
10. Connection to m. bearing °M
11. Connection to m. bearing °M
12. Connection to m. bearing °M
13. Diff. Ht. is m. ^{above} below
14. Diff. Ht. is m. ^{above} below
15. Diff. Ht. is m. ^{above} below
16. Diff. Ht. is m. ^{above} below

Date **1928** Record of Station **Station Established**

Noted on U.T.M. Card

Checked:

Checked

Prepared by:

CENTRAL MAPPING AUTHORITY

GEODETIC SURVEY OF NSW

GEODETIC STATION RECONNAISSANCE and MAINTENANCE REPORT

STATION: **HOLLOW ROCK** TS No.: **2497**


MAP SHEET SCALE 1:250 000 **SYDNEY**

INSPECTED BY: **G JONES** DATE: **18-4-80**

AUTHORITY: **CMA** FIELD BOOK: **01880**

Description: *Note: Cross out word or words which do not apply*

1. Cleared by lanes bearing..... *See diagram*..... from Trig. Mast
2. Mast & Vanes have been painted white & black respectively.
3. The station/pillar was unpiled/not unpiled/constructed on..... 19..... dimensions now being: *Drill hole and frame in rock*
Description of mark..... should be explicit, e.g., S/Steel Pillar Plate, Steel plug, Brass plug, Bolt, G.I. Pipe
Height of mark..... m. ^{above} _{below} rock/concrete; Mark is..... m. ^{above} _{below} G.L.
- Height of Top Vanes to Top Mark/Pillar plate m. Diameter of Vanes (vertical)..... m.
- Height of Cairn..... m. Diameter of Cairn..... m. Name Plate found/not found/placed.
- Length of Mast m. (approximate if not unpiled)
4. A..... set in conc/rock has been placed/found, bearing..... °M from Mast/Plug/Pillar
5. A..... set in conc/rock has been placed/found, bearing..... °M from Mast/Plug/Pillar
6. A..... set in conc/rock has been placed/found, bearing..... °M from Mast/Plug/Pillar
7. A..... set in conc/rock has been placed/found, bearing..... °M from Mast/Plug/Pillar
8. Action required..... *Not to be contacted between 255 and 265*..... *between 255 and 265*.....

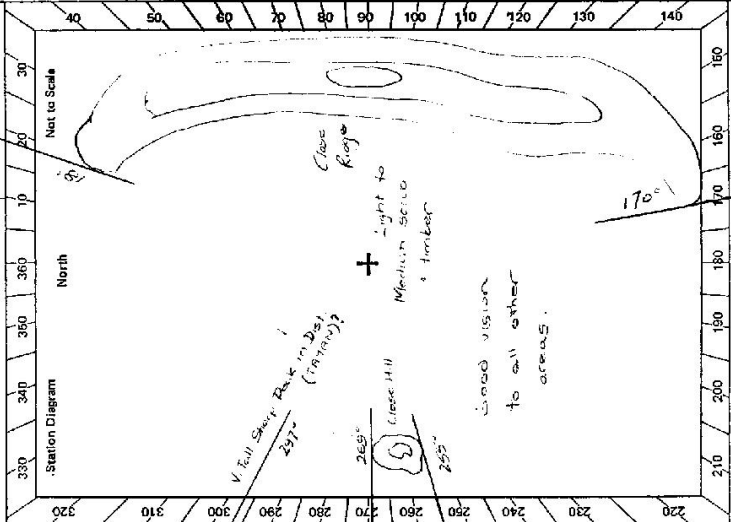

STANDPOINT:			
Mark	Direction	Horiz. Distance	Height Difference
			above standpt.
			below standpt.
			above standpt.
			below standpt.
Prepared by: *J. G. Jones* Checked: *G. Jones* Noted on U.T.M. Card

<p>Beacon Diagram</p> <div style="border: 1px solid black; padding: 5px; margin: 5px 0;"> <p style="text-align: right;">Not to Scale</p> <p style="text-align: center; font-weight: bold;">DRILL HOLE AND TRIANGLE IN ROCK FOUND (Cont'd of Hollow Rock)</p> <p style="text-align: center; font-weight: bold;">NO BEACON</p> </div>	<table border="1" style="width:100%; border-collapse: collapse;"> <tr> <td style="width: 20%; text-align: center;">STATION</td> <td>HOLLOW ROCK</td> <td style="width: 20%; text-align: center;">TS-2497</td> </tr> <tr> <td>Owner's Name:</td> <td colspan="2">WOLEMI NATIONAL PARK</td> </tr> <tr> <td>Address:</td> <td colspan="2">.....</td> </tr> <tr> <td>Phone:</td> <td colspan="2">.....</td> </tr> <tr> <td>Current Occupant:</td> <td colspan="2">.....</td> </tr> <tr> <td>Address:</td> <td colspan="2">.....</td> </tr> <tr> <td>Phone:</td> <td colspan="2">.....</td> </tr> <tr> <td>ACCESS</td> <td colspan="2">(4WD ONLY) (CALL WEATHER)</td> </tr> <tr> <td>Access Report of 18/4/1988 was found suitable/unsuitable.</td> <td colspan="2">.....</td> </tr> <tr> <td>0.00</td> <td colspan="2">COLO RIVER BRIDGE ON PUTTY ROAD. Travel towards Singleton ✓</td> </tr> <tr> <td>12.55</td> <td colspan="2">COLO HEIGHTS PUBLIC SCHOOL on R.H.S. ✓</td> </tr> <tr> <td>33.30</td> <td colspan="2">Turn left off PUTTY ROAD onto dirt track, heading ✓ in NW direction.</td> </tr> <tr> <td>34.21</td> <td colspan="2">Take right fork ✓</td> </tr> <tr> <td>35.43</td> <td colspan="2">Straight ahead. Track on right ✓</td> </tr> <tr> <td>43.61</td> <td colspan="2">Straight ahead. Track on right to SIX BROTHERS TS. ✓</td> </tr> <tr> <td>44.24</td> <td colspan="2">Take left fork ✓</td> </tr> <tr> <td>45.29</td> <td colspan="2">Dam on right ✓</td> </tr> <tr> <td>46.00</td> <td colspan="2">Take right fork ✓</td> </tr> <tr> <td>46.14</td> <td colspan="2">Turn right off track + head along ridge. ✓ 150m walk to trig ✓</td> </tr> </table>	STATION	HOLLOW ROCK	TS-2497	Owner's Name:	WOLEMI NATIONAL PARK		Address:		Phone:		Current Occupant:		Address:		Phone:		ACCESS	(4WD ONLY) (CALL WEATHER)		Access Report of 18/4/1988 was found suitable/unsuitable.		0.00	COLO RIVER BRIDGE ON PUTTY ROAD. Travel towards Singleton ✓		12.55	COLO HEIGHTS PUBLIC SCHOOL on R.H.S. ✓		33.30	Turn left off PUTTY ROAD onto dirt track, heading ✓ in NW direction.		34.21	Take right fork ✓		35.43	Straight ahead. Track on right ✓		43.61	Straight ahead. Track on right to SIX BROTHERS TS. ✓		44.24	Take left fork ✓		45.29	Dam on right ✓		46.00	Take right fork ✓		46.14	Turn right off track + head along ridge. ✓ 150m walk to trig ✓	
STATION	HOLLOW ROCK	TS-2497																																																								
Owner's Name:	WOLEMI NATIONAL PARK																																																									
Address:																																																									
Phone:																																																									
Current Occupant:																																																									
Address:																																																									
Phone:																																																									
ACCESS	(4WD ONLY) (CALL WEATHER)																																																									
Access Report of 18/4/1988 was found suitable/unsuitable.																																																									
0.00	COLO RIVER BRIDGE ON PUTTY ROAD. Travel towards Singleton ✓																																																									
12.55	COLO HEIGHTS PUBLIC SCHOOL on R.H.S. ✓																																																									
33.30	Turn left off PUTTY ROAD onto dirt track, heading ✓ in NW direction.																																																									
34.21	Take right fork ✓																																																									
35.43	Straight ahead. Track on right ✓																																																									
43.61	Straight ahead. Track on right to SIX BROTHERS TS. ✓																																																									
44.24	Take left fork ✓																																																									
45.29	Dam on right ✓																																																									
46.00	Take right fork ✓																																																									
46.14	Turn right off track + head along ridge. ✓ 150m walk to trig ✓																																																									
<p>This section to be completed by officer constructing pillar.</p> <p>Original station mark found/not found.</p> <p>Description of mark: Drill hole in rock (with triangle).....</p> <p>Original beacon found/not found.</p> <p>Description of beacon:</p> <p>Height Top of Vanes to Top Markm.</p> <p>Height of mark.....m above rock/conc.....m, below G.L.</p> <p>Diameter of Vanesm. Height of Cairnm.</p> <p>Original Beacon has/has not been destroyed by me.</p>	<table border="1" style="width:100%; border-collapse: collapse;"> <tr> <td style="width: 50%; text-align: center;">Date</td> <td style="width: 50%; text-align: center;">Record of Station</td> </tr> <tr> <td>.....</td> <td>.....</td> </tr> <tr> <td>.....</td> <td>.....</td> </tr> <tr> <td>.....</td> <td>.....</td> </tr> </table>	Date	Record of Station																																																	
Date	Record of Station																																																									
.....																																																									
.....																																																									
.....																																																									