

CENTRAL MAPPING AUTHORITY

Department of Lands

RECONNAISSANCE and MAINTENANCE REPORT

STATION **HOLMAN** TS **2498**

This Trig. Station has been:-

Note: Cross out word or words which do not apply

1. Completely cleared to permit 360° vision to surrounding Trias.
2. Cleared by lanes bearing 330° to 30° M., 50° M., 105° M., 145° M. from Trig. Mast
3. Trig. Mast & Vanes have been painted white & black respectively.

4. The Trig. was unpiled/not unpiled, dimensions now being: ~~0.7m x 0.7m x 2.0m~~

Description of mark should be explicit, e.g. Steel plug, Brass plug, Bolt, G.I. Pipe

Height of mark m above rock/concrete m below G.L.

Height of Top Vanes to Top Mark m. Diameter of Vanes (vertical) 0.7 m.

Height of Cairn 2.0 m. Diameter of Cairn 2.0 m.


Length of Mast 3.6 m. (approximate if not unpiled)

5. A. set in conc/rock has been placed m. bearing °M from Trig. Mast
6. A. set in conc/soil has been placed m. bearing °M from Trig. Mast
7. A. set in conc/soil has been placed m. bearing °M from Trig. Mast
8. A. set in conc/rock has been placed m. bearing °M from Trig. Mast
9. Connection to m. bearing °M *Note: Site suitable for pillar. Cairn crumbling. Mast rotten. Vanes unpainted.*
10. Connection to ~~to No. 1~~ m. bearing °M
11. Connection to m. bearing °M
12. Connection to m. bearing °M
13. Diff. Ht. is m. ~~above below~~
14. Diff. Ht. is m. ~~above below~~
15. Diff. Ht. is m. ~~above below~~
16. Diff. Ht. is m. ~~above below~~

Prepared by: M. Berge 4-11-76. Checked: Noted on U.T.M. Card

Co: **SELWYN** Ph: **JINGELLE East** TS **2498**
 Map Sheet: **ROSEWOOD** No: **8426**
 Incorporated by: **N.D. Berge** Date: **27 October 1976**
 Authority: **CENTRAL MAPPING** Field Book:

Beacon Diagram Not to Scale

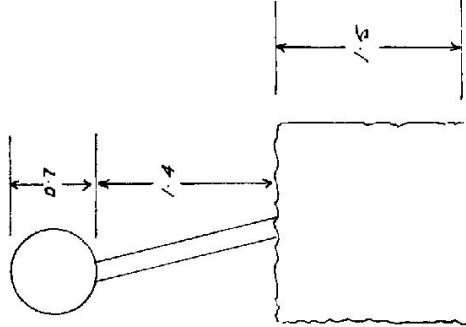


Date Record of Station

Checked


STATION HOLMAN TS 2498

Owners Name.....
Address.....
Current Occupant.....
Address.....

27-10-1976
Access Refer to Currnie 8426-11-5 1:25,000
North
A Holman TS.

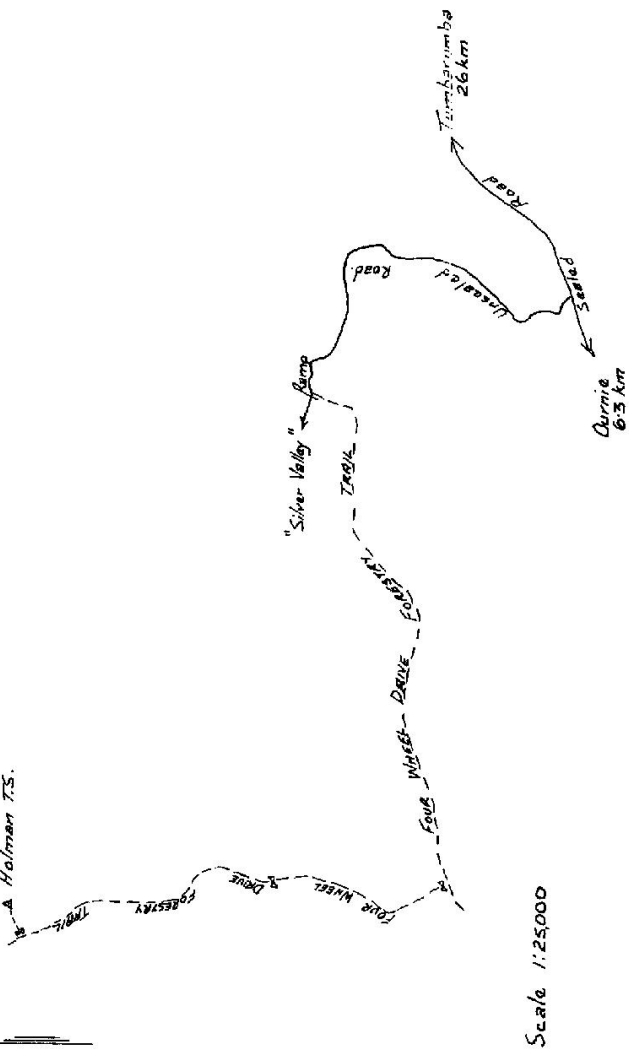

Scale 1:25,000

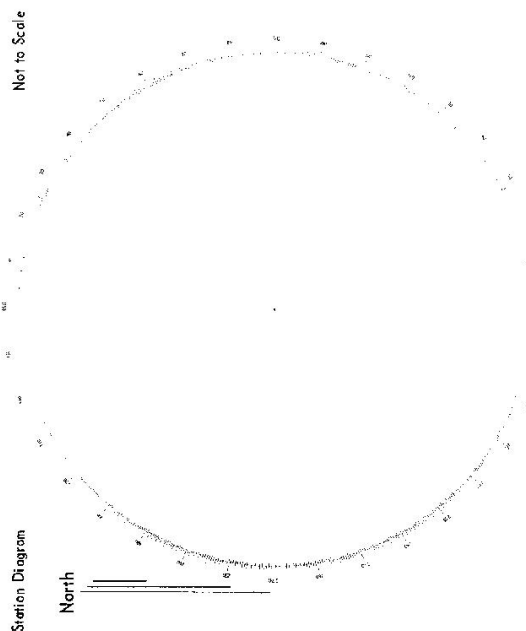

List of Observed Directions:-

Standpoint:		Station	
Station	Direction	Station	Direction

Station	Direction	Station	Direction