

CENTRAL MAPPING AUTHORITY

GEODETIC SURVEY OF N.S.W.  
 GEODETIC STATION RECONNAISSANCE and MAINTENANCE REPORT

Description:

- Note: Cross out word or words which do not apply
1. Cleared by lanes bearing... ~~Blocked~~ by hills... 90:170... 4:280-50M
  2. ~~Mast & Vanes have been painted white & black respectively~~ Beacon in fair condition
  3. The station/pillar was applied/not applied/constructed on... 19... dimensions now being:  
 Description of mark... should be explicit, e.g., S/Steel Pillar Plate, Steel plug, Brass plug, Bolt, G.I. Pipe  
 Height of mark... m. above rock/concrete; Mark is... m. above G.L.  
 Height of Top Vanes to Top Mark... 2.9 m. Diameter of Vanes (vertical)... 0.93 m.  
 Height of Cairn... 1.5 m. Diameter of Cairn... 2 m. Name Plate found/not found/placed.  
 Length of Mast... 4.4 m. (approximate if not unplied)
  4. A... set in conc/rock has been placed/found, bearing... °M from Mast/Plug/Pillar
  5. A... set in conc/rock has been placed/found, bearing... °M from Mast/Plug/Pillar
  6. A... set in conc/rock has been placed/found, bearing... °M from Mast/Plug/Pillar
  7. A... set in conc/rock has been placed/found, bearing... °M from Mast/Plug/Pillar
  8. Action required: CANYON LEIGH 1:31680

STANDPOINT:

Mark	Direction	Horiz. Distance	Height Difference	Mark	Direction	Horiz. Distance	Height Difference
			above standpt				above standpt
			below				below
			above standpt				above standpt
			below				below
Prepared by:

Noted on U.T.M. Card

ST 2783-1

Checked

STATION: HOLT TS 2501 No.:

MAP SHEET SCALE 1:250 000 Wollongong

INSPECTED BY: A. Sivertsen DATE: 3-11-78

AUTHORITY: CMA FIELD BOOK: 1717

Station Diagram


North

Useless G.S. site

Not to Scale

Sr 2733-2 D. West Government Printer

STATION **HOLT TS 2501**

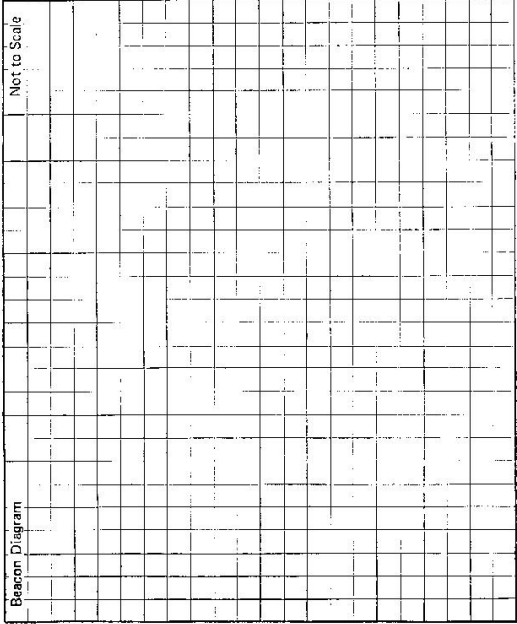

Owner's Name: .....  
 Address: .....  
 Phone: .....  
 Current Occupant: .....  
 Address: .....  
 Phone: .....

ACCESS

Access Report of...../19.....was found suitable/unavailable.

- 0.0 At 5-way intersection in BRAYTON (Abt 9km from MARULAN)  
 Take BUNNABY 30 BIG HILL IS road
- 3.0 Wollondilly River
- 3.2 Turn R along gravel road
- 3.8 Gate
- 3.9 Take R fork
- 4.4 Gate
- 5.3 Take R fork through gate
- 5.4 Take R fork through gate then go down lane & turn left along fence before dam
- 6.6 Cross creek
- 6.9 Gate
- 6.10 Gate
- 6.3 Take R fork along fence
- 6.3 Gate
- 6.55 Veer R off track at crest of spur
- 6.6 Δ HOLT

This section to be completed by officer constructing pillar.

Original station mark found/not found.

Description of mark: .....

Original beacon found/not found.

Description of beacon: .....

Height Top of Vanes to Top Mark.....m.

Height of mark.....m. above G.L. / below rock/conc.....m. below

Diameter of Vanes .....m. Height of Cairn .....m.

Original Beacon has/has not been destroyed by me.

Date: .....  
 Name of Station: .....