

Department of Lands Integrity Survey of N.S.W.
RECONNAISSANCE and MAINTENANCE REPORT

This Trig. Station has been:- Note: Cross out word or words which do not apply

1. Completely cleared to permit 360° vision to surrounding Trigs.
2. Cleared by lanes bearing from Trig. Mast
3. Trig. Mast & Vanes have been painted white & black respectively.
4. The Trig. was unpiled/not unpiled, dimensions now being:


Description of mark should be explicit, e.g. Steel plug, Brass plug, Bolt, Concrete Pillar
 Height of mark m ^{above} rock, concrete m ^{below} G.L.
 Height of Top Vanes to Top Mark/Top pillar plate m Diameter of Vanes (vertical) m.
 Height of Cairn m. Diameter of Cairn m.
 Length of Mast m. (approximate if not unpiled)

5. A set in conc./rock has been placed/fd m. bearing°M from Trig. Mast/pillar
6. A set in conc./soil has been placed/fd m. bearing°M from Trig. Mast/pillar
7. A set in conc./soil has been placed/fd m. bearing°M from Trig. Mast/pillar
8. A set in conc./rock has been placed/fd m. bearing°M from Trig. Mast/pillar

9. Connection to m. bearing°M
10. Connection to m. bearing°M
11. Connection to m. bearing°M
12. Connection to m. bearing°M
13. Diff. Ht. is m. ^{above} _{below}
14. Diff. Ht. is m. ^{above} _{below}
15. Diff. Ht. is m. ^{above} _{below}
16. Diff. Ht. is m. ^{above} _{below}

Prepared by: P. O'Kane Checked:

STATION HUNGRY (P) TS 2533
 Co: DL RHAM Ph: HOUGHTON
 Map Sheet: Paterson 9432-IV-N No: ID 25
 Inspected by: P. O'Kane Date: 10/8/89
 Authority: LIC, Newcastle Field Book:

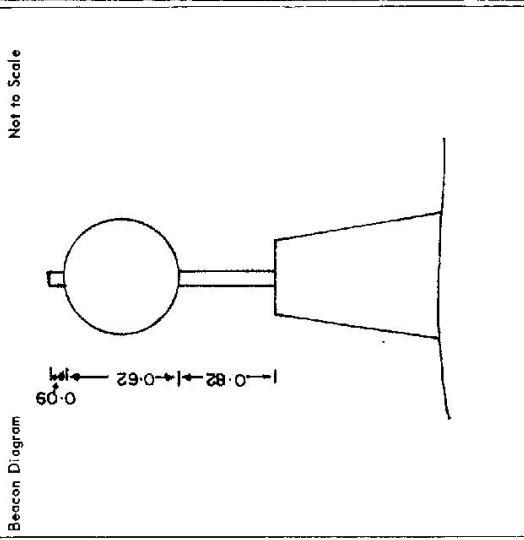

Date	Record of Station
10/8/89	New Mast & Vanes, New Access

