

CENTRAL MAPPING AUTHORITY


GEODETIC SURVEY OF N.S.W.
 GEODETIC STATION RECONNAISSANCE and MAINTENANCE REPORT

STATION: LEADERS GS No.: 2547

MAP SHEET
 SCALE 1:250 000 COORDED TO D.A.A.

INSPECTED BY: PLANTS DATE: 5.8.80.

AUTHORITY: INA FIELD BOOK: 1681

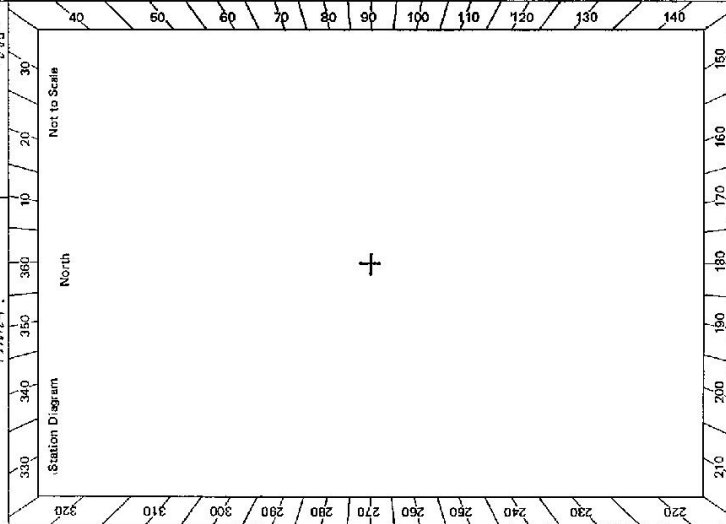


- Description: 36.0°
1. Cleared by lanes bearing 36.0° *Note: Cross out word or words which do not apply* from Trig. Mast
2. Mast & Vanes have been painted white & black respectively.
3. The station was unspiled / constructed on 5.0 19.0 dimensions now being: 5.0 should be explicit, e.g., S/Steel Pillar Plate, Steel plug, Brass plug, Bolt, G.I. Pipe
- Description of mark: was unspiled
- Height of mark 1.0 m. ^{above} / _{below} rock/concrete; Mark is 1.0 m. ^{above} / _{below} G.L.
- Height of Top Vanes to Top Mark/Pillar plate 1.0 m. Diameter of Vanes (vertical) 0.75 m.
- Height of Cairn 1.0 m. Diameter of Cairn 1.0 m. Name Plate found/not found/placed.
- Length of Mast 3.385 m. (approximate if not unspiled) ✓
4. A. set in conc/rock has been placed/found, bearing.....° M from Mast/Plug/Pillar
5. A. set in conc/rock has been placed/found, bearing.....° M from Mast/Plug/Pillar
6. A. set in conc/rock has been placed/found, bearing.....° M from Mast/Plug/Pillar
7. A. set in conc/rock has been placed/found, bearing.....° M from Mast/Plug/Pillar
8. Action required: TO BE REPLACED

STANDPOINT:			
Mark	Direction	Horiz. Distance	Height Difference
			above standpt.
			below standpt.
			above standpt.
			below standpt.
Prepared by: PLANTS Checked: PLANTS Noted on U.T.M. Card

SI 2733-2 D. West, Government Printer

STATION *IZANDI G.* TS 2547

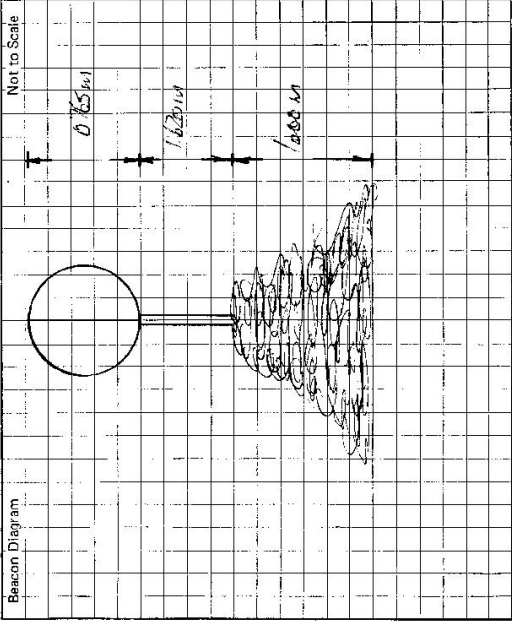

Owner's Name:
 Address:
 Phone:

Current Occupant:
 Address:
 Phone:

ACCESS

Access Report of 5.8.1988 was found suitable/unsuitable.
 1km. ~~LEARNER~~
 0.00. PD. DEERWATHA. HEAD TOWARDS YOUNG.
 0.10. TURN LEFT AND OLYMPIC WAY AND HEAD TOWARDS YOUNG.
 7.90. 1800L (KORANHUIS) ON RIGHT (CORNER).
 0.75. TURN RIGHT SIGN YOUNG VIA SCENIC DRIVE
 1006. CROSS RAILWAY LINE
 1075. BRIDGE
 17.70. PASS ROAD ON RIGHT SIGN "BURNIES ROAD"
 18.80. PASS ROAD ON RIGHT SIGN "YOUNG"
 19.20. TURN RIGHT SIGN "GREEN THORPE"
 21.80. TURN LEFT SIGN "YOUNG"
 22.40. IZANDI G. ON RIGHT TOP SIDE OF ROAD

This section to be completed by officer constructing pillar.

Original station mark found/not found.

Description of mark:

Original beacon found/not found.

Description of beacon:

Height Top of Vanes to Top Markm.

Height of markm. above G.L.
 below

Diameter of Vanesm. Height of Cairnm.

Original Beacon has/has not been destroyed by me.

Date	Record of Station