

CENTRAL MAPPING AUTHORITY
Department of Lands

Trigonometrical Survey of N.S.W.

RECONNAISSANCE and MAINTENANCE REPORT

This Trig. Station has been:-

Note: Cross out word or words which do not apply

1. ~~Completely cleared to permit 360° vision to surrounding Trig.~~
2. Cleared by lances bearing 202°M / 279°M / 352°M from Trig. Mast
3. Trig. Mast & Vanes have been painted white & black respectively. ✓
SMA = QUADRUPOD
4. The Trig. ~~was supplied with~~ ^{was supplied with} dimensions now being:

Description of mark STEEL P.L.A.G. should be explicit, e.g. Steel plug, Brass plug, Bat, G.I. Pipe
 Height of mark 0.31 m above ~~rock/concrete~~ ^{rock/concrete} below 0.31 m above G.L.
 Height of Top Vanes to Top Mark 3.93 m. SQUARE Diameter of Vanes (vertical) 0.31 m.

Height of Cairn 1.22 m. Diameter of Cairn 0.07 m.

Length of Mast 1.22 m. (approximate if not unplied)

5. A. ~~set in conc/rock has been placed~~ set in conc/rock has been placed m. bearing°M from Trig. Mast
6. A. ~~set in conc/soil has been placed~~ set in conc/soil has been placed m. bearing°M from Trig. Mast
7. A. ~~set in conc/soil has been placed~~ set in conc/soil has been placed m. bearing°M from Trig. Mast
8. A. ~~set in conc/rock has been placed~~ set in conc/rock has been placed m. bearing°M from Trig. Mast


9. Connection to m. bearing°M
10. Connection to m. bearing°M
11. Connection to m. bearing°M
12. Connection to m. bearing°M

13. Diff. Ht. is m. ^{above} ~~below~~
14. Diff. Ht. is m. ^{above} ~~below~~
15. Diff. Ht. is m. ^{above} ~~below~~
16. Diff. Ht. is m. ^{above} ~~below~~

Prepared By: P. ROHNER

Checked: Noted on U.T.M. Card

STATION INDI GS TS 2556
 Co: INDI GS TS 2556
 Map Sheet: KOSCIUSKO 1:100,000 No: 8525
 Inspected by: ROHNER Date: 26-1-77
 Authority: CMA Field Book: 1526

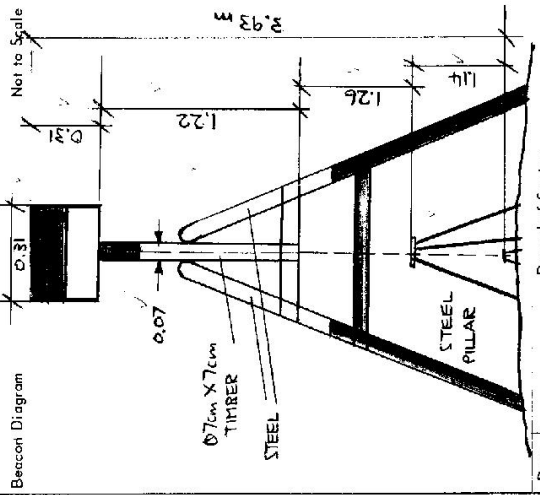

Date: _____ Record of Station

LAND INFORMATION CENTRE

GEODETTIC SURVEY OF A.S.M.

GEODETTIC STATION RECONNAISSANCE and MAINTENANCE REPORT

STATION: **INDI** No.: **2556**

Description:

1. Cleared by lanes bearing **NO LANES CLEARED ONLY FAIR FOR GPS** from Trig. Mast
 Note: *Cross out word or words which do not apply*

2. Mast & Vanes have been painted white & black respectively.

3. The station/pillar was unpiled/not unpiled/constructed of.....19....., dimensions now being:

Description of mark **BRASS PLUG IN ROCK** should be explicit, e.g., S/Steel Pillar Plate, Steel plug, Brass plug, Bolt, G.I. Pipe

Height of mark.....m. ^{above} rock/concrete; Mark is.....m. ^{above} G.L.

SMA - QUADRIPOD - WITH STEEL PILLAR CONSTRUCTION OVER TRIG MUG.
 Height of Top Vanes to Top Mark/Pillar platem. Diameter of Vanes (vertical).....m.

Height of Cairn.....m. Diameter of Cairn.....m. Name Plate found/not found/placed.

Length of Mastm. (approximate if not unpiled)

4. A.....set in conc/rock has been placed/found; bearing.....° M. from Mast/Plug/Pillar

5. A.....set in conc/rock has been placed/found; bearing.....° M. from Mast/Plug/Pillar

6. A.....set in conc/rock has been placed/found; bearing.....° M. from Mast/Plug/Pillar

7. A.....set in conc/rock has been placed/found; bearing.....° M. from Mast/Plug/Pillar

8. Action required:.....

STANDPOINT:

STANDPOINT:

Mark	Direction	Horiz. Distance	Height Difference	Mark	Direction	Horiz. Distance	Height Difference
			above standpt.				above standpt.
			below				below
			above standpt.				above standpt.
			below				below
Prepared by: *[Signature]* 3/4/95

Checked: *[Signature]* Noted on U.T.M. Card

