

CENTRAL MAPPING AUTHORITY  
Department of Lands

Trigonometrical Survey of N.S.W.

RECONNAISSANCE and MAINTENANCE REPORT

STATION INGBERAH G.S.

TS 2558

This Trig. Station has been:-

Note: Cross out word or words which do not apply

1. Completely cleared to permit 360° vision to surrounding Trig.
2. Cleared by lanes bearing 315° - 340° M. from Trig. Mast
3. Trig. Mast & Vanes have been painted white & black respectively.
4. The Trig. was unpainted/not unpainted, dimensions now being: should be explicit, e.g. Steel plug, Brass plug, Bolt, G.I. Pipe

Description of mark.....

Height of mark..... m above rock/concrete G.L.  
Height of Top Vanes to Top Mark..... m. Diameter of Vanes (vertical) 0.764 m.


Height of Cairn 1.66m m. Diameter of Cairn 1.7m m.  
Length of Mast 3.4m m. (approximate if not unpiled)

5. A..... set in conc/rock has been placed..... m. bearing.....°M from Trig. Mast
6. BRIDGE SPIKE set in conc/soil has been placed 25.12 m. bearing.....°M from Trig. Mast
7. BRIDGE SPIKE set in conc/soil has been placed 4.74 m. bearing 233°M from Trig. Mast
8. A..... set in conc/rock has been placed..... m. bearing.....°M from Trig. Mast

9. Connection..... to..... m. bearing.....°M
10. Connection..... to..... m. bearing.....°M
11. Connection..... to..... m. bearing.....°M
12. Connection..... to..... m. bearing.....°M
13. Diff. Ht. BRIDGE SPIKE is 7.48 m. below Bottom of vanes Ingerah G.S.
14. Diff. Ht. BRIDGE SPIKE is 0.3 m. above G.I. PIPE PLACED
15. Diff. Ht. is..... m. above
16. Diff. Ht. is..... m. above

Prepared by: A. Woodruff. Checked: A. Woodruff. Noted on U.T.M. Card

Co: STATION INGBERAH G.S. TS 2558  
Map Sheet: JACOBS RIVER No: 8524-N  
Inspected by: A. WOODRUFF Date: 26/1/77  
Authority: CENTRAL MAPPING. Field Book: 1530.  
Beacon Diagram Not to Scale

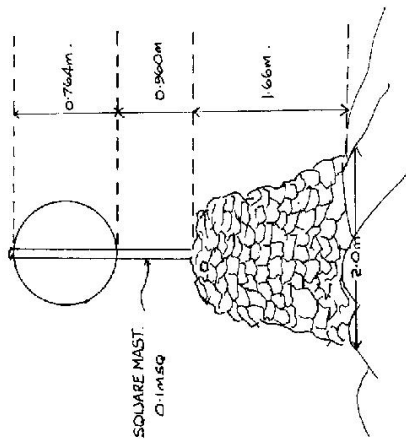

Date	Record of Station

STATION INGEBIRAH G.S. TS 2558

Current Occupant: .....  
 Address: .....

Owners Name: .....  
 Address: .....

Access 26-1-1977  
 MILEAGE

DESCRIPTION:

JINDABNEPO. GOTOWARDS KHANCOBAN

TURN LEFT TOWARDS INGEBYRA

TAKE RIGHT FORK TOWARDS JACOBS RIVER.

CHURCH ON R.H.S. - CARRY STRAIGHT AHEAD.

BRIDGE AND START OF DIRT ROAD.

PROPERTY INGEBIRAH - PM BLAZE ON TREE. TURN RIGHT OVER RAMP.

HOUSE AND SHEDS. TURN LEFT BEFORE FENCE (SEE OWNER.) FOLLOW VALLEY UP.

FROM DAM TRIG HAS BEARING 270M.


GO THROUGH OLD WOOD GATE. CARRY ON TOWARDS HILL.

CROSS CREEK BY WOODEN BRIDGE. DRIVE AS FAR AS POSSIBLE & WALK TO TRIG (APPROX 45 MINS.)

Not to Scale

Station Diagram

GODNorth

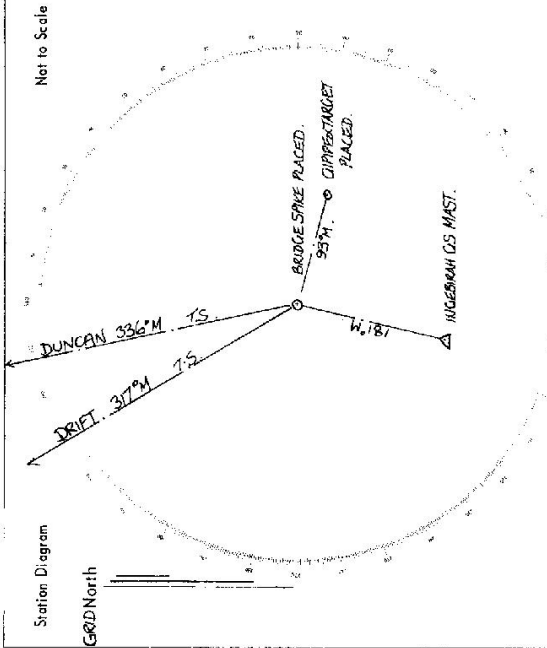

List of Observed Directions:-

Standpoint: BRIDGE SPIKE PLACED		Standpoint:	
Station	Direction	Station	Direction
DRIFT	75		
DUNCAN	19°05' 58.5		
CORRECT TARGET PLACED	140°28'		
INGEBIRAH	224°19' 25.5		
MAST	R.H.S. 224°36.45		

Station	Direction	Station	Direction