

CENTRAL MAPPING AUTHORITY

GEODETIC STATION RECONNAISSANCE and MAINTENANCE REPORT

- Description: *Note: Cross out word or words which do not apply*
- Cleared by lances bearing..... from Trig. Mast
  - Mast & Vanes have been painted white & black respectively.
  - The station/pillar was unpiled/not unpiled/constructed on....., dimensions now being:
    - Description of mark..... should be explicit, e.g., S/Steel Pillar Plate, Steel plug, Brass plug, Bolt, G.I. Pipe
    - Height of mark.....m. above/below rock/concrete; Mark is.....m. above/below G.L.
    - Height of Top Vanes to Top Mark/Pillar plate.....m. Diameter of Vanes (vertical).....m.
    - Height of Cairn.....m. Diameter of Cairn.....m. Name Plate found/not found.....
    - Length of Mast.....m. (approximate if not unpiled)
  - A..... set in conc/rock has been placed/found, bearing.....° M from Mast/Plug/Pillar
  - A..... set in conc/rock has been placed/found, bearing.....° M from Mast/Plug/Pillar
  - A..... set in conc/rock has been placed/found, bearing.....° M from Mast/Plug/Pillar
  - A..... set in conc/rock has been placed/found, bearing.....° M from Mast/Plug/Pillar
  - Action required:.....

STANDPOINT:

Mark	Direction	Horiz. Distance	Height Difference	Direction	Horiz. Distance	Height Difference
			above standpt.			above standpt.
			below standpt.			below standpt.
			above standpt.			above standpt.
			below standpt.			below standpt.
Prepared by: *[Signature]*

Checked: *[Signature]*

Noted on U.T.M. Card

STATION: *INVERARY GS.* TS No.: *2561*  
 MAP SHEET SCALE 1:250 000 *GOULBURN*  
 INSPECTED BY: *M. L. MacGILLIVRAY* DATE: *2-11-78*  
 AUTHORITY: *C.M.A.* FIELD BOOK: *1711*

Station Diagram

Not to Scale

North

STATION <b>INVERARY G.S. TS 2561</b>	Owner's Name: ..... Address: ..... Phone: ..... Current Occupant: ..... Address: ..... Phone: .....	Access Report of <b>2.11.19</b> was found suitable/unsuitable. <b>ACCESS</b> <b>Directions</b> <b>0.00 BUNGONIA RD. HEAD EAST ALONG INVERARY RD.</b> <b>0.65 GRID+GATE</b> <b>5.30 GO STRAIGHT AHEAD PAST GRID+GATE ON LEFT.</b> <b>5.70 GRID+GATE SIGN INVERARY PARK</b> <b>6.20 TAKE R.H. FORK</b> <b>6.40 GATE. PASS DIAGONALLY BEHIND HOUSE FOLLOW TRACK.</b> <b>GATE</b> <b>6.50 TURN LEFT PASS OLD HOUSE ON YOUR LEFT.</b> <b>GATE UNDER POWER LINES.</b> <b>7.00 TURN RIGHT AT END OF TREE LINE</b> <b>7.40 PASS RUINS OF OLD HOUSE ON LEFT.</b> <b>GATE TRIG STRAIGHT AHEAD</b> <b>INVERARY G.S.</b>
Beacon Diagram Not to Scale 	This section to be completed by officer constructing pillar. Original station mark found/not found. Description of mark: ..... Original beacon found/not found. Description of beacon: ..... Height Top of Vanes to Top Mark ..... m. Height of mark ..... m. above G.L. / below G.L. Diameter of Vanes ..... m. Height of Cairn ..... m. Original Beacon has/has not been destroyed by me.	
Date	Record of Station	

GEODETTIC SURVEY OF N.S.W.

CENTRAL MAPPING AUTHORITY

GEODETTIC STATION RECONNAISSANCE and MAINTENANCE REPORT

STATION: INVIGARY LIGHT STN. No: 2561  
 MAP SHEET SCALE 1:250 000  
 INSPECTED BY: D. J. KAIN DATE: 24 May 1984  
 AUTHORITY: C.M.A. FIELD BOOK: 1954  
 Station Diagram:

- Description:
1. Cleared by lanes bearing As per station diagram from Trig. Mast  
 Note: Cross out word or words which do not apply
  2. Mast & Vanes have been painted white & black respectively \*
  3. The station/pillar was ~~unplaced~~/not unplaced/constructed on 2.4 m. x 1.9 m. x 1.9 m., dimensions now being: CAIRN MAST  
 Description of mark. MAST should be explicit, e.g., S/Steel Pillar Plate, Steel plug, Brass plug, Bolt, G.I. Pipe  
 Height of mark 0 m. above/below rock/concrete; Mark is 0 m. above/below G.L.  
 Height of Top Vanes to Top Mark/Pillar plate 1.5 m. to top Diameter of Vanes (vertical) 30 m.  
 Height of Cairn 0 m. Diameter of Cairn 0 m. Name Plate found/not found/placed.  
 Length of Mast 3.72 m. (approximate if not unplaced)
  4. A 0 set in conc/rock has been placed/found, bearing 0° M from Mast/Plug/Pillar
  5. A 0 set in conc/rock has been placed/found, bearing 0° M from Mast/Plug/Pillar
  6. A 0 set in conc/rock has been placed/found, bearing 0° M from Mast/Plug/Pillar
  7. A 0 set in conc/rock has been placed/found, bearing 0° M from Mast/Plug/Pillar
  8. Action required:


STANDPOINT:			
Mark	Direction	Horiz. Distance	Height Difference
			above standpt.
			below standpt.
			above standpt.
			below standpt.
Prepared by: D. J. KAIN Checked: [Signature]  
 Noted on U.T.M. Card

STATION INNERARY GEDDETHI STATION 2561 TS

**PRELIMINARY**  
 Owner's Name: MR. PHILIP MARSH BROADHEAD  
 Address: INNERARY PARK, Bungonia  
 Phone: (048) 434 295  
 Current Occupant: .....  
 Address: .....  
 Phone: .....  
 ACCESS 24-5-1984

Access Report of 7/11/1978 was found ~~suitable~~/unsuitable.  
**FEATURE**  
KMS  
 0.00 AT BUNGNIA POST OFFICE, TRAVEL EAST ALONG INNERARY ROAD.  
 3.65 GRID AND GATE.  
 5.30 GO STRAIGHT AHEAD PAST GRID AND GATE ON LEFT.  
 5.70 GRID AND GATE SIGN, INNERARY PARK.  
 6.20 TAKE RIGHT HAND FORK.  
 6.40 GATE PASS DIAGONALLY BEHIND HOUSE (ACCESS AND OWNERS HOUSE) FOLLOW TRACK.  
 6.45 GATE TRAVEL STRAIGHT AHEAD.  
 6.50 TAKE LEFT FORK IN TRACKS.  
 6.72 PASS SHEARING SHED AND YARDS ON YOUR L.H.S.  
 6.77 THROUGH IRON GATE, TURN LEFT DOWN FENCE.  
 6.87 THROUGH IRON GATE, FOLLOW TRACK.  
 7.09 THROUGH IRON GATE, KEEP FOLLOWING TRACK ALONG FENCE.  
 7.58 INNERARY-GEDDETHI STATION.

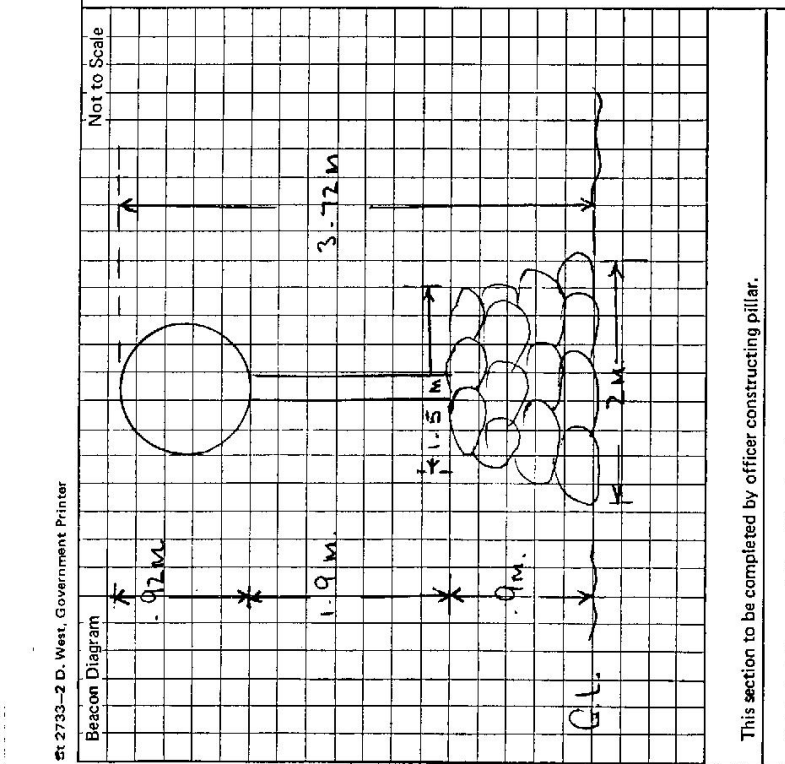

This section to be completed by officer constructing pillar.  
 Original station mark found/not found.  
 Description of mark: .....  
 Original beacon found/not found.  
 Description of beacon: .....  
 Height Top of Vanes to Top Mark .....m.  
 Height of mark: .....m. above rock/conc .....m. below G.L.  
 Diameter of Vanes .....m. Height of Cairn .....m.  
 Original Beacon has/has not been destroyed by me.

Date	Record of Station