

CENTRAL MAPPING AUTHORITY

GEODETIC STATION RECONNAISSANCE and MAINTENANCE REPORT

STATION: IRBY No.: 2562

MAP SHEET SCALE 1:250 000


INSPECTED BY: GREG DICKSON

DATE: 28-11-79

AUTHORITY: C.M.A. FIELD BOOK: 1804

Description: *Note: Cross out word or words which do not apply*

1. Cleared by lanes bearing..... from Trig. Mast
2. Mast & Vanes have been painted white & black respectively.
3. The station/pillar was unplied/not unplied/constructed on..... 19....., dimensions now being:
 - Description of mark..... should be explicit, e.g., S/Steel Pillar Plate, Steel plug, Brass plug, Bolt, G.I. Pipe
 - Height of mark.....m. ^{above} _{below} rock/concrete; Mark is.....m. ^{above} _{below} G.L.
 - Height of Top Vanes to Top Mark/Pillar plate.....m. Diameter of Vanes (vertical).....m.
 - Height of Cairn.....m. Diameter of Cairn.....m. Name ~~Plate~~ found/lost found/placed.
 - Length of Mast.....m. (approximate if not unplied)
4. A..... set in conc/rock has been placed/found, bearing.....° M from Mast/Plug/Pillar
5. A..... set in conc/rock has been placed/found, bearing.....° M from Mast/Plug/Pillar
6. A..... set in conc/rock has been placed/found, bearing.....° M from Mast/Plug/Pillar
7. A..... set in conc/rock has been placed/found, bearing.....° M from Mast/Plug/Pillar
8. Action required: ESTIMATE / MARK REMOVAL BY LANE MAST / PILLAR SCALE

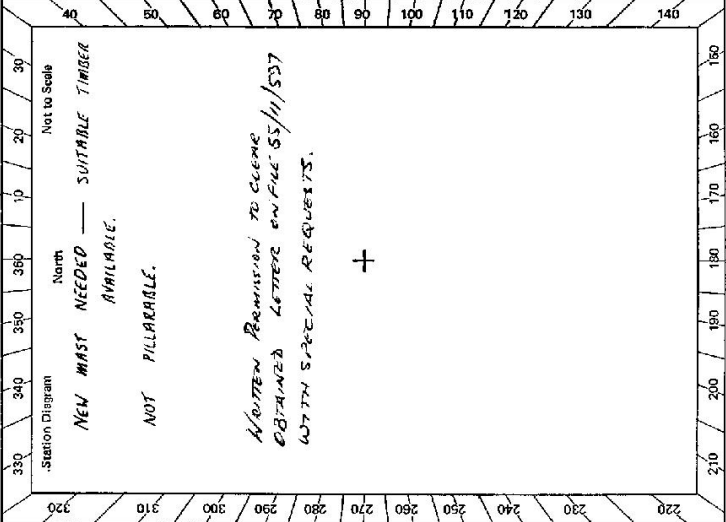

STANDPOINT:			
Mark	Direction	Horiz. Distance	Height Difference
			above standpt
			below standpt
			above standpt
			below standpt
Prepared by: *Greg Dickson*

Checked: *Greg Dickson*


Noted on U.T.M. Card

STATION **IRBY TS 2562**

Owner's Name: **SEAFORD CHURCH WARFARMY**
 Address: **BLUFF ROCK WA. FORTREVERED.**
(PO BOX 243, TEMPERLEIGH)
 Phone: **067 867769**
 Current Occupant:
 Address:
 Phone:

ACCESS

Access Report of **23.11.1979** was found suitable/unsuitable.
FEATURES.
 0.0 P.O. TENTENFIELD TRAIL SOUTH TOWARD GLEN HARP.
 12.7 CROSS BLUFF CREEK.
 14.0 CROSS RAILWAY
 16.9 TURN RIGHT OFF HIGHWAY OPPOSITE SKIN 'STEP BECKET'
 16.55 IRON GATE - THRU GATE AND HARD N.W. TO BASE OF RAKE ON RIGHT.
 16.75 PASS UNDER POWER LINE
 17.35 TURN RIGHT THRU OLD FENCE LINE OLD CONTACT TO LEFT.
 YELLOW PRINT AN POST - WERE LEFT UP TOWARD SANDY
 HAT'S NEST DETACHED RUSTED TRUCKS FOLLOW ALRED TRACK
 SLIPSTYX BELOW MET.
 17.75 STOP VEHICLE AT ALBEDO. WALK UP RIDGE TO VERY STEEP RUGH
 TREN FOLLOW ANIMAL TRACKS AROUND WESTERN SIDE AND UP
 MARK SOUTH THRU RINGBARRED TIMBER ACROSS THE SADDLE
 UP THE MEET PATCH AND SOUTH ALONG TOP TO TRAIL.
 60 m WALK

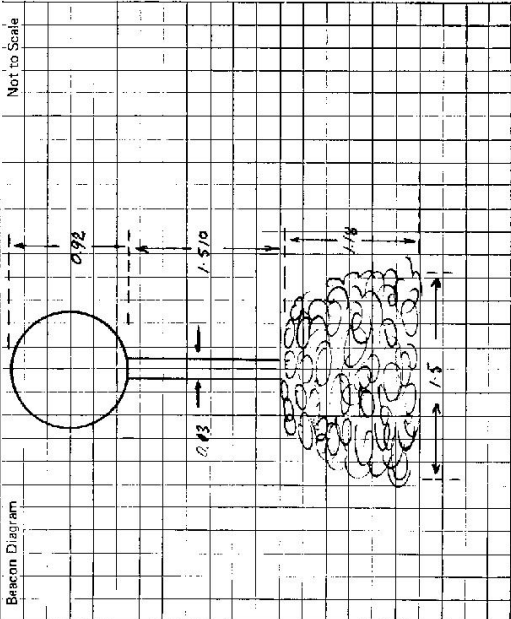

This section to be completed by officer constructing pillar.

Original station mark found/not found.
 Description of mark:
 Original beacon found/not found.
 Description of beacon:
 Height Top of Vanes to Top Mark m.
 Height of mark m. above G.L.
 below
 Diameter of Vanes m. Height of Callin m.
 Original Beacon has/has not been destroyed by me.

Date	Record of Station

<p>STATION IRBY GS TS 2562</p>	<p>Owner's Name: Stamela CHARLES WARTMAY Address: BLUFF ROCK VIA TENTERFIELD PO BOX 243 TENTERFIELD Phone: 067 367269</p> <p>Current Occupant: Address: Phone:</p> <p style="text-align: center;">ACCESS</p> <p>Access Report of 28/11/1988 was found suitable/unsuitable.</p> <p>0-00 PO TENTERFIELD TRAVEL SOUTH TOWARDS GLEN INNES 14-3 CROSS BLUFF CREEK 14-10 CROSS RAILWAY 16-4 TURN RIGHT OFF HWY OPPOSITE SIGN STEEP DESCENT 16-65 IRON GATE - THEN HEAD N.W TO BASE OF RIDGE ON RIGHT 16-70 PASS UNDER POWER LINE 16-75 TURN RIGHT THEN OLD FENCE LINE OLD COTTAGE TO LEFT 17-35 YELLOW PANT ON POST - VEER LEFT UP TOWARDS SANDY ANTENNAS 17-75 STOP VEHICLE AT BLAZES (DRIVE FURTHER WITH WING) WALK UP RIDGE TO VERY STEEP PINCH THEN FOLLOW ANIMAL TRACKS AROUND EASTERN SIDE AND UP. WALK SOUTH THROUGH RING-BANKED TIMBER ACROSS THE SADDLE UP THE NEXT PINCH AND SOUTH ALONG TOP TO TRIC 45 - 60 m WALK.</p>	<p>Beacon Diagram</p> <p style="text-align: right;">Not to Scale</p>
<p>This section to be completed by officer constructing pillar.</p> <p>Original station mark found/not found.</p> <p>Description of mark: CARRIDGE CASE IN CONC</p> <p>Original beacon found/not found.</p> <p>Description of beacon: CALIBAL MAST & VANES</p> <p>Height Top of Vanes to Top Mark: 3.605 m.</p> <p>Height of mark: 0 m. above G.L. AI m. below G.L.</p> <p>Diameter of Vanes: 0.915 m. Height of Cairn: 1.80 m.</p> <p>Original Beacon has/has not been destroyed by me.</p>		<p>Date</p> <p>Record of Station</p>